


1 LOCATION OF WATER WELL: County: **Ford** Fraction: $\frac{1}{4}$ **S1/2** $\frac{1}{4}$ **SW** $\frac{1}{4}$ Section Number: **20** Township Number: **T 26 S** Range Number: **R 24 E** **(NW)**

Distance and direction from nearest town or city street address of well if located within city?
2 Miles North of Dodge City

2 WATER WELL OWNER: **Ford County Landfill**
 RR#, St. Address, Box #: **Jetmore Star Route** Board of Agriculture, Division of Water Resources
 City, State, ZIP Code: **Dodge City, Ks. 67801** **8S** Application Number:

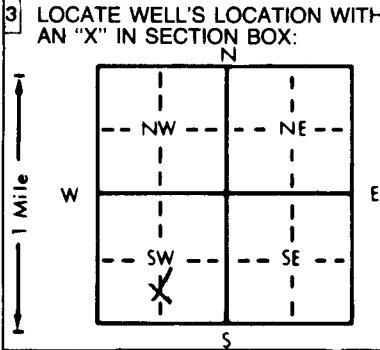

4 DEPTH OF COMPLETED WELL: **145** ft. ELEVATION: _____ ft.
 Depth(s) Groundwater Encountered 1. _____ ft. 2. _____ ft. 3. _____ ft.
 WELL'S STATIC WATER LEVEL **124.98** ft. below land surface measured on mo/day/yr
 Pump test data: Well water was _____ ft. after _____ hours pumping _____ gpm
 Est. Yield _____ gpm: Well water was _____ ft. after _____ hours pumping _____ gpm
 Bore Hole Diameter **8** in. to **145** ft., and _____ in. to _____ ft.
 WELL WATER TO BE USED AS:
 5 Public water supply 8 Air conditioning 11 Injection well
 1 Domestic 3 Feedlot 6 Oil field water supply 9 Dewatering 12 Other (Specify below)
 2 Irrigation 4 Industrial 7 Lawn and garden only 10 Monitoring well
 Was a chemical/bacteriological sample submitted to Department? Yes _____ No **X** _____; If yes, mo/day/yr sample was submitted
 Water Well Disinfected? Yes _____ No **X** _____

5 TYPE OF BLANK CASING USED:
 1 Steel 3 RMP (SR) 5 Wrought iron 8 Concrete tile CASING JOINTS: Glued _____ Clamped _____
 2 PVC 4 ABS 6 Asbestos-Cement 9 Other (specify below) Welded _____
 7 Fiberglass Threaded **X**
 Blank casing diameter **4** in. to **125** ft. Dia _____ in. to _____ ft. Dia _____ in. to _____ ft.
 Casing height above land surface **30** in. weight **2.071** lbs./ft. Wall thickness or gauge No. **.237**
 TYPE OF SCREEN OR PERFORATION MATERIAL:
 1 Steel 3 Stainless steel 5 Fiberglass 7 PVC 10 Asbestos-cement
 2 Brass 4 Galvanized steel 6 Concrete tile 8 RMP (SR) 11 Other (specify) _____
 9 ABS 12 None used (open hole)
 SCREEN OR PERFORATION OPENINGS ARE:
 1 Continuous slot 3 Mill slot 5 Gauzed wrapped 8 Saw cut 11 None (open hole)
 2 Louvered shutter 4 Key punched 6 Wire wrapped 9 Drilled holes
 7 Torch cut 10 Other (specify) _____
 SCREEN-PERFORATED INTERVALS: From **125** ft. to **145** ft. From _____ ft. to _____ ft.
 From _____ ft. to _____ ft. From _____ ft. to _____ ft.
 GRAVEL PACK INTERVALS: From **120** ft. to **145** ft. From _____ ft. to _____ ft.
 From _____ ft. to _____ ft. From _____ ft. to _____ ft.

6 GROUT MATERIAL: 1 Neat cement 2 Cement grout 3 Bentonite 4 Other
 Grout Intervals: From **0** ft. to **112** ft. From **112** ft. to **120** ft. From _____ ft. to _____ ft.
 What is the nearest source of possible contamination:
 1 Septic tank 4 Lateral lines 7 Pit privy 10 Livestock pens 14 Abandoned water well
 2 Sewer lines 5 Cess pool 8 Sewage lagoon 11 Fuel storage 15 Oil well/Gas well
 3 Watertight sewer lines 6 Seepage pit 9 Feedyard 12 Fertilizer storage 16 Other (specify below) **Landfill**
 13 Insecticide storage
 Direction from well? _____ How many feet? _____

FROM	TO	LITHOLOGIC LOG	FROM	TO	PLUGGING INTERVALS
0	2	Surface	133	145	Fine Sand w/a Few Clay Lenses
2	14	Loess			
14	34.5	Clay & Caliche Strks.			
34.5	50	Caliche w/Clay Strks.			
50	52	Rock Shelf w/Sand			
52	56	Cemented Sand w/a Few Sand St.			
56	57	Med. Sand			
57	76	Cemented Sand w/Caliche			
76	83	Fine to Med. Sand w/Clay Lens			
83	103	Sandy Clay w/Caliche&SomeSand			
103	110	Caliche w/Sandy Clay			
110	119	Caliche, Clay & Sand Lenses			
119	121	Med. Sand & Gravel/Clay Lenses			
121	128	Clay, Caliche & Some Sand			
128	133	Fine Sand w/Clay Strks.			

7 CONTRACTOR'S OR LANDOWNER'S CERTIFICATION: This water well was (1) constructed, (2) reconstructed, or (3) plugged under my jurisdiction and was completed on (mo/day/year) **8-14-94** and this record is true to the best of my knowledge and belief. Kansas Water Well Contractor's License No. **554** This Water Well Record was completed on (mo/day/yr) **9-21-94** under the business name of **Woofter Pump & Well, Inc.** by (signature) *Jay C. Woofter*