


1 LOCATION OF WATER WELL: Fraction $\frac{1}{4}$ S1/2 $\frac{1}{4}$ SW $\frac{1}{4}$ Section Number 20 Township Number T 26 S Range Number R 24 EW

Distance and direction from nearest town or city street address of well if located within city?
 2 Miles North of Dodge City

2 WATER WELL OWNER: Ford County Landfill
 RR#, St. Address, Box #: Jetmore Star Route Board of Agriculture, Division of Water Resources
 City, State, ZIP Code: Dodge City, Ks. 67801 4D Application Number:

3 LOCATE WELL'S LOCATION WITH AN "X" IN SECTION BOX:

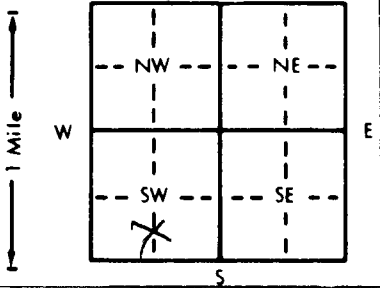

4 DEPTH OF COMPLETED WELL: 211 ft. ELEVATION:

Depth(s) Groundwater Encountered 1. ft. 2. ft. 3. ft.
 WELL'S STATIC WATER LEVEL: 142.28 ft. below land surface measured on mo/day/yr
 Pump test data: Well water was ft. after hours pumping gpm
 Est. Yield gpm: Well water was ft. after hours pumping gpm
 Bore Hole Diameter 8 in. to 211 ft., and in. to ft.
 WELL WATER TO BE USED AS:
 5 Public water supply 8 Air conditioning 11 Injection well
 1 Domestic 3 Feedlot 6 Oil field water supply 9 Dewatering 12 Other (Specify below)
 2 Irrigation 4 Industrial 7 Lawn and garden only 10 Monitoring well
 Was a chemical/bacteriological sample submitted to Department? Yes No X; If yes, mo/day/yr sample was submitted
 Water Well Disinfected? Yes No X

5 TYPE OF BLANK CASING USED:
 1 Steel 3 RMP (SR) 5 Wrought iron 8 Concrete tile CASING JOINTS: Glued Clamped
 2 PVC 4 ABS 6 Asbestos-Cement 9 Other (specify below) Welded
 7 Fiberglass Threaded X
 Blank casing diameter 4 in. to 1.91 ft., Dia. in. to ft., Dia. in. to ft.
 Casing height above land surface 30 in., weight 2,071 lbs./ft. Wall thickness or gauge No. 237

TYPE OF SCREEN OR PERFORATION MATERIAL:
 1 Steel 3 Stainless steel 5 Fiberglass 7 PVC 10 Asbestos-cement
 2 Brass 4 Galvanized steel 6 Concrete tile 8 RMP (SR) 11 Other (specify)
 12 None used (open hole)

SCREEN OR PERFORATION OPENINGS ARE:
 1 Continuous slot 3 Mill slot 5 Gauzed wrapped 8 Saw cut 11 None (open hole)
 2 Louvered shutter 4 Key punched 6 Wire wrapped 9 Drilled holes
 7 Torch cut 10 Other (specify)

SCREEN-PERFORATED INTERVALS: From 191 ft. to 211 ft., From ft. to ft.
 From ft. to ft., From ft. to ft.
 GRAVEL PACK INTERVALS: From 186 ft. to 211 ft., From ft. to ft.
 From ft. to ft., From ft. to ft.

6 GROUT MATERIAL: 1 Neat cement 2 Cement grout 3 Bentonite 4 Other
 Grout Intervals: From 0 ft. to 177 ft., From 177 ft. to 186 ft., From ft. to ft.

What is the nearest source of possible contamination:
 1 Septic tank 4 Lateral lines 7 Pit privy 10 Livestock pens 14 Abandoned water well
 2 Sewer lines 5 Cess pool 8 Sewage lagoon 11 Fuel storage 15 Oil well/Gas well
 3 Watertight sewer lines 6 Seepage pit 9 Feedyard 12 Fertilizer storage 16 Other (specify below) Landfill
 13 Insecticide storage
 Direction from well? How many feet?

FROM	TO	LITHOLOGIC LOG	FROM	TO	PLUGGING INTERVALS
0	2	Surface	134	152	Fine to Med. Sand
2	5	Loess	152	155	Clay
5	20	Silty Clay	155	160	Fine to Med. Sand/Clay Layers
20	25	Silt, Med. Brown Caliche	160	167	Clay Caliche & Sand Strks.
25	30	Silt	167	175	Caliche & Clay Strks.
30	40	Caliche	175	180	Fine Sand & Caliche
40	65	Caliche & Clay & Sand Strks.	180	184	Fine Sand
65	77	Sand & Caliche & Clay Strks.	184	185	Caliche
77	81	Med. Sand	185	197	Med Sand w/Caliche Strks.
81	85	Clay	197	202	Sticky Clay/Weathered Shale
85	90	Sandy silt & Clay	202	211	Sticky Clay & Caliche Strks.
90	95	Silty Sand/Clay & Caliche St.			
95	105	Cemented Sand & Clay Strks.			
105	121	Med. Sand/Clay & Caliche Strk			
121	134	Sticky Tan Clay			

7 CONTRACTOR'S OR LANDOWNER'S CERTIFICATION: This water well was (1) constructed, (2) reconstructed, or (3) plugged under my jurisdiction and was completed on (mo/day/year) 9-8-94 and this record is true to the best of my knowledge and belief. Kansas Water Well Contractor's License No. 554 This Water Well Record was completed on (mo/day/yr) 9-22-94 under the business name of Woofter Pump & Well, Inc. by (signature) Jay C. Woofter