


1 LOCATION OF WATER WELL: County: **Ford** Fraction: $\frac{1}{4}$ **S1/2** $\frac{1}{4}$ **SW** $\frac{1}{4}$ Section Number: **20** Township Number: **T 26 S** Range Number: **R 24 EW**

Distance and direction from nearest town or city street address of well if located within city?
2 Miles North of Dodge City

2 WATER WELL OWNER: **Ford County Landfill**
 RR#, St. Address, Box #: **Jetmore Star Route** Board of Agriculture, Division of Water Resources
 City, State, ZIP Code: **Dodge City, Ks. 67801** **9S** Application Number:

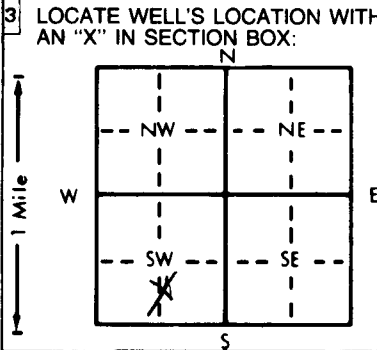

4 DEPTH OF COMPLETED WELL: **155** ft. ELEVATION: _____
 Depth(s) Groundwater Encountered 1. _____ ft. 2. _____ ft. 3. _____ ft.
 WELL'S STATIC WATER LEVEL **137.93** ft. below land surface measured on mo/day/yr
 Pump test data: Well water was _____ ft. after _____ hours pumping _____ gpm
 Est. Yield _____ gpm: Well water was _____ ft. after _____ hours pumping _____ gpm
 Bore Hole Diameter **8** in. to **1.55** ft., and _____ in. to _____ ft.
 WELL WATER TO BE USED AS: 5 Public water supply 8 Air conditioning 11 Injection well
 1 Domestic 3 Feedlot 6 Oil field water supply 9 Dewatering 12 Other (Specify below)
 2 Irrigation 4 Industrial 7 Lawn and garden only 10 Monitoring well
 Was a chemical/bacteriological sample submitted to Department? Yes _____ No **X**; If yes, mo/day/yr sample was submitted
 Water Well Disinfected? Yes _____ No **X**

5 TYPE OF BLANK CASING USED: 5 Wrought iron 8 Concrete tile CASING JOINTS: Glued _____ Clamped _____
 1 Steel 3 RMP (SR) 6 Asbestos-Cement 9 Other (specify below) Welded _____
 2 PVC 4 ABS 7 Fiberglass _____ Threaded **X**
 Blank casing diameter **4** in. to **1.35** ft., Dia _____ in. to _____ ft., Dia _____ in. to _____ ft.
 Casing height above land surface **30** in., weight **2.071** lbs./ft. Wall thickness or gauge No. **237**
 TYPE OF SCREEN OR PERFORATION MATERIAL: 7 PVC 10 Asbestos-cement
 1 Steel 3 Stainless steel 5 Fiberglass 8 RMP (SR) 11 Other (specify) _____
 2 Brass 4 Galvanized steel 6 Concrete tile 9 ABS 12 None used (open hole)
 SCREEN OR PERFORATION OPENINGS ARE: 5 Gauzed wrapped 8 Saw cut 11 None (open hole)
 1 Continuous slot 3 Mill slot 6 Wire wrapped 9 Drilled holes
 2 Louvered shutter 4 Key punched 7 Torch cut 10 Other (specify) _____
 SCREEN-PERFORATED INTERVALS: From **135** ft. to **155** ft., From _____ ft. to _____ ft.
 From _____ ft. to _____ ft., From _____ ft. to _____ ft.
 GRAVEL PACK INTERVALS: From **130** ft. to **155** ft., From _____ ft. to _____ ft.
 From _____ ft. to _____ ft., From _____ ft. to _____ ft.

6 GROUT MATERIAL: 1 Neat cement 2 Cement grout 3 Bentonite 4 Other _____
 Grout Intervals: From **0** ft. to **124** ft., From **124** ft. to **130** ft., From _____ ft. to _____ ft.
 What is the nearest source of possible contamination: 10 Livestock pens 14 Abandoned water well
 1 Septic tank 4 Lateral lines 7 Pit privy 11 Fuel storage 15 Oil well/Gas well
 2 Sewer lines 5 Cess pool 8 Sewage lagoon 12 Fertilizer storage 16 Other (specify below)
 3 Watertight sewer lines 6 Seepage pit 9 Feedyard 13 Insecticide storage **Landfill**

Direction from well? _____ How many feet? _____

FROM	TO	LITHOLOGIC LOG	FROM	TO	PLUGGING INTERVALS
0	4	Surface	94.5	100	Sandy Clay w/Caliche Strks.
4	12	Loess	100	111	Sticky Clay w/A Few Caliche/
12	36	Clay & Caliche Strks.	111	118	Sandy Clay w/Caliche Streaks
36	40	Clay&Caliche w/Some Fine Sand	118	119	Sticky Clay
40	43	Sandy Silt	119	123	Fine Sand w/Clay Streaks
43	50	Sandy Clay w/Caliche Strks.	123	129	Sandy Clay & Caliche w/SandS
50	63	Caliche w/Clay Strks.	129	134	Med.Sand & Gravel
63	70	Med. Sand & Gravel w/Clay St.	134	145	Sandy Clay w/Caliche Strks.
70	71	Cemented Sand	145	150	Fine Sand w/Clay
71	72	Fine to Med. Sand	150	155	Fine to Med. Sand w/Clay
72	82	Caliche & Cemented Sand w/a few Sand Strks.			Streaks
82	87	Clay w/Caliche Strks.			
87	93	Fine to Med. Sand w/Clay Strk.			
93	94.5	Med. Sand & Gravel			

7 CONTRACTOR'S OR LANDOWNER'S CERTIFICATION: This water well was (1) constructed, (2) reconstructed, or (3) plugged under my jurisdiction and was completed on (mo/day/year) **9-14-94** and this record is true to the best of my knowledge and belief. Kansas Water Well Contractor's License No. **554** This Water Well Record was completed on (mo/day/yr) **9-22-94** under the business name of **Woofter Pump & Well, Inc.** by (signature) *Paul C. Woofter*