


1 LOCATION OF WATER WELL: Fraction $\frac{1}{4}$ S $1\frac{1}{2}$ $\frac{1}{4}$ SW $\frac{1}{4}$ Section Number 20 Township Number T 26 S Range Number R 24 EW

Distance and direction from nearest town or city street address of well if located within city?
 2 Miles North of Dodge City

2 WATER WELL OWNER: Ford County Landfill
 RR#, St. Address, Box #: Jetmore Star Route Board of Agriculture, Division of Water Resources
 City, State, ZIP Code: Dodge City, Ks. 67801 7S Application Number:

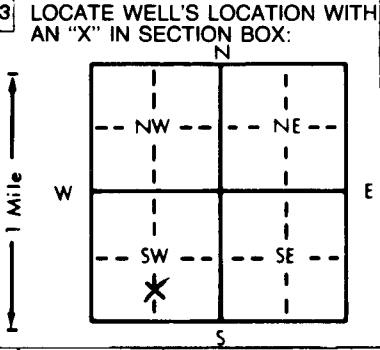

4 DEPTH OF COMPLETED WELL 162 ft. ELEVATION:
 Depth(s) Groundwater Encountered 1. ft. 2. ft. 3. ft.
 WELL'S STATIC WATER LEVEL 148.84 ft. below land surface measured on mo/day/yr
 Pump test data: Well water was ft. after hours pumping gpm
 Est. Yield gpm: Well water was ft. after hours pumping gpm
 Bore Hole Diameter 8 in. to 162 ft. and in. to ft.
 WELL WATER TO BE USED AS:
 5 Public water supply 8 Air conditioning 11 Injection well
 1 Domestic 3 Feedlot 6 Oil field water supply 9 Dewatering 12 Other (Specify below)
 2 Irrigation 4 Industrial 7 Lawn and garden only 10 Monitoring well
 Was a chemical/bacteriological sample submitted to Department? Yes No X; If yes, mo/day/yr sample was submitted
 Water Well Disinfected? Yes No X

5 TYPE OF BLANK CASING USED:
 1 Steel 3 RMP (SR) 5 Wrought iron 8 Concrete tile CASING JOINTS: Glued Clamped
 2 PVC 4 ABS 6 Asbestos-Cement 9 Other (specify below) Welded
 7 Fiberglass Threaded X
 Blank casing diameter 4 in. to 142 ft. Dia in. to ft. Dia in. to ft.
 Casing height above land surface 30 in. weight 2.071 lbs./ft. Wall thickness or gauge No. .237
 TYPE OF SCREEN OR PERFORATION MATERIAL:
 1 Steel 3 Stainless steel 5 Fiberglass 7 PVC 10 Asbestos-cement
 2 Brass 4 Galvanized steel 6 Concrete tile 8 RMP (SR) 11 Other (specify)
 12 None used (open hole)
 SCREEN OR PERFORATION OPENINGS ARE:
 1 Continuous slot 3 Mill slot 5 Gauzed wrapped 8 Saw cut 11 None (open hole)
 2 Louvered shutter 4 Key punched 6 Wire wrapped 9 Drilled holes
 7 Torch cut 10 Other (specify)
 SCREEN-PERFORATED INTERVALS: From 142 ft. to 162 ft. From ft. to ft.
 From ft. to ft. From ft. to ft.
 GRAVEL PACK INTERVALS: From 137 ft. to 162 ft. From ft. to ft.
 From ft. to ft. From ft. to ft.

6 GROUT MATERIAL: 1 Neat cement 2 Cement grout 3 Bentonite 4 Other
 Grout Intervals: From 0 ft. to 131 ft. From 131 ft. to 137 ft. From ft. to ft.
 What is the nearest source of possible contamination:
 1 Septic tank 4 Lateral lines 7 Pit privy 10 Livestock pens 14 Abandoned water well
 2 Sewer lines 5 Cess pool 8 Sewage lagoon 11 Fuel storage 15 Oil well/Gas well
 3 Watertight sewer lines 6 Seepage pit 9 Feedyard 12 Fertilizer storage 16 Other (specify below)
 13 Insecticide storage Landfill
 Direction from well? How many feet?

FROM	TO	LITHOLOGIC LOG	FROM	TO	PLUGGING INTERVALS
0	8	Fill Dirt	115	117	Sandy Clay
8	18	Sandy Clay w/Caliche Strks.	117	120	Sandy Clay w/Fine to Med. Sand Strks. & Caliche
18	54	Drk. Brwn Clay w/a Few Caliche			
54	59	Sandy Clay w/Caliche Str.	120	130.5	Sandy Clay w/Caliche Strks.
59	77	Sticky Clay	130.5	140	Sandy Clay w/Cemented Sand,
77	80	Sandy Silt	140	144	Med. Sand & Gravel w/Cem. Sand
80	87	Caliche & Sandy Clay	144	150	Sandy Clay w/Caliche Strks.
87	91	Med. Sand & Gravel w/Clay Str	150	156	Clay
91	93	Caliche w/Clay Strks.	156	160	Sandy Clay w/Sand Strks.
93	95	Fine to Med. Sand & Gravel w/	160	162	Fine Sand w/Clay Strks.
		Clay Strks.			
95	100	Cemented Sand w/Sandy Clay &			
		Sand Strks.			
100	105.5	Med. Sand & Gravel w/Clay Str			
105.5	115	Sandy Clay w/Sand & Caliche St.			

7 CONTRACTOR'S OR LANDOWNER'S CERTIFICATION: This water well was (1) constructed, (2) reconstructed, or (3) plugged under my jurisdiction and was completed on (mo/day/year) 9-15-94 and this record is true to the best of my knowledge and belief. Kansas Water Well Contractor's License No. 554 This Water Well Record was completed on (mo/day/yr) 9-23-94 under the business name of Woofter Pump & Well, Inc. by (signature) *Gayle Woofter*