WATER WELL RECORD Form WWC-5 KSA 82a-1212

1 LOCATION OF WATER WELL: County: Ford | Fraction: NW ¼ SE ¼ SE ¼ | Section Number: 30 | Township Number: T 26 S | Range Number: R 24 E(W)

Distance and direction from nearest town or city street address of well if located within city? Dodge City Truck Stop 2524 E. Wyatt Earp, Dodge City KS.

2 WATER WELL OWNER: Sand

RR#, St. Address, Box # : PO Box 1456 MW 4

City, State, ZIP Code : Dodge City, KS.

Board of Agriculture, Division of Water Resources Application Number:

3 LOCATE WELL'S LOCATION WITH AN "X" IN SECTION BOX:

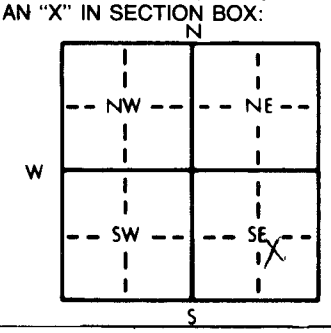

4 DEPTH OF COMPLETED WELL. . . . . ft. ELEVATION: . . . . .

Depth(s) Groundwater Encountered 1. . . . . ft. 2. . . . . ft. 3. 81.0 ft.

WELL'S STATIC WATER LEVEL Cole. 1 ft. below land surface measured on mo/day/yr 8/28/94

Pump test data: Well water was . . . ft. after . . . hours pumping . . . gpm

Est. Yield . . . gpm: Well water was . . . ft. after . . . hours pumping . . . gpm

Bore Hole Diameter 8 in. to . . . ft., and . . . in. to . . . ft.

WELL WATER TO BE USED AS: 1 Domestic 2 Irrigation 3 Feedlot 4 Industrial 5 Public water supply 6 Oil field water supply 7 Lawn and garden only 8 Air conditioning 9 Dewatering (10) Monitoring well 11 Injection well 12 Other (Specify below)

Was a chemical/bacteriological sample submitted to Department? Yes (No); If yes, mo/day/yr sample was submitted

Water Well Disinfected? Yes (No)

5 TYPE OF BLANK CASING USED: 1 Steel (2 PVC) 3 RMP (SR) 4 ABS 5 Wrought iron 6 Asbestos-Cement 7 Fiberglass 8 Concrete tile 9 Other (specify below)

CASING JOINTS: Glued . . . Clamped . . . Welded . . . (Threaded)

Blank casing diameter 2 in. to . . . ft., Dia . . . in. to . . . ft., Dia . . . in. to . . . ft.

Casing height above land surface 0 in., weight . . . lbs./ft. Wall thickness or gauge No. . . .

TYPE OF SCREEN OR PERFORATION MATERIAL: (7 PVC)

1 Steel 2 Brass 3 Stainless steel 4 Galvanized steel 5 Fiberglass 6 Concrete tile 8 RMP (SR) 9 ABS 10 Asbestos-cement 11 Other (specify) 12 None used (open hole)

SCREEN OR PERFORATION OPENINGS ARE: (1 Continuous slot) 2 Louvered shutter 3 Mill slot 4 Key punched 5 Gauzed wrapped 6 Wire wrapped 7 Torch cut 8 Saw cut 9 Drilled holes 10 Other (specify) 11 None (open hole)

SCREEN-PERFORATED INTERVALS: From 60.5 ft. to 85.5 ft., From . . . ft. to . . . ft.

From . . . ft. to . . . ft., From . . . ft. to . . . ft.

GRAVEL PACK INTERVALS: From 59.5 ft. to 85.5 ft., From . . . ft. to . . . ft.

From . . . ft. to . . . ft., From . . . ft. to . . . ft.

6 GROUT MATERIAL: (1 Neat cement) 2 Cement grout (3 Bentonite) 4 Other . . .

Grout Intervals: From 0 ft. to 57.5 ft., From 57.5 ft. to 59.5 ft., From . . . ft. to . . . ft.

What is the nearest source of possible contamination: 1 Septic tank 2 Sewer lines 3 Watertight sewer lines 4 Lateral lines 5 Cess pool 6 Seepage pit 7 Pit privy 8 Sewage lagoon 9 Feedyard 10 Livestock pens (11 Fuel storage) 12 Fertilizer storage 13 Insecticide storage 14 Abandoned water well 15 Oil well/Gas well 16 Other (specify below)

Direction from well? NNW How many feet? 100

FROM	TO	LITHOLOGIC LOG	FROM	TO	PLUGGING INTERVALS
0	7.0	Top soil w/ clay dark brn			
7	17.0	clay, light brown			
17	45.0	caliche + tan w/ sand + silt			
45.0	60.0	sand - med. to coarse			
60	85.5	clay w/ sand, silt, + gravel - petro odor			

7 CONTRACTOR'S OR LANDOWNER'S CERTIFICATION: This water well was (1) constructed, (2) reconstructed, or (3) plugged under my jurisdiction and was completed on (mo/day/year) 8-16-94 and this record is true to the best of my knowledge and belief. Kansas Water Well Contractor's License No. 438 This Water Well Record was completed on (mo/day/yr) 8-19-94 under the business name of KCTL by (signature)

INSTRUCTIONS: Use typewriter or ball point pen. *PLEASE PRESS FIRMLY* and *PRINT* clearly. Please fill in blanks, underline or circle the correct answers. Send top three copies to Kansas Department of Health and Environment, Bureau of Water, Topeka, Kansas 66620-0001. Telephone: 913-296-5545. Send one to WATER WELL OWNER and retain one for your records.

OFFICE USE ONLY T R E/W SEC. ¼ ¼ ¼