




1 LOCATION OF WATER WELL: Fraction **SW 1/4 SW 1/4 1/4** Section Number **26** Township Number **T 26 S** Range Number **R 25W**  
 COUNTY: FORD

Distance and direction from nearest town or city street address of well if located within city?  
**ON 14TH STREET & FORD-ENSIGN ROAD**

2 WATER WELL OWNER: **DODGE CITY COOPERATIVE**  
 RRF, St. Address, Box #: **WEST TRAIL STREET** Board of Agriculture, Division of Water Resources  
 City, State, ZIP code: **DODGE CITY, KS 67801-** Application Number:

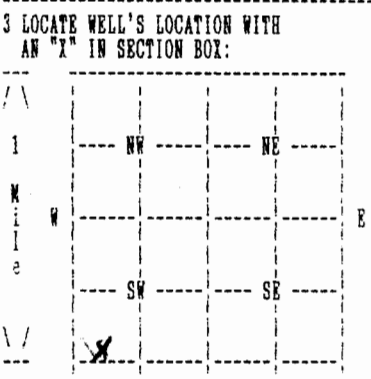

4 DEPTH OF COMPLETED WELL **205** ELEVATION: **0**  
 Depth(s) Groundwater Encountered 1. **0 ft.** 2. **0 ft.** 3. **0 ft.**  
 WELL'S STATIC WATER LEVEL **0 ft.** below land surface measured on **no/day/yr**  
 Pump test data: Well water was **0 ft.** after **0** hours pumping **0 gpm**  
 Estimated Yield **0 gpm**: Well water was **0 ft.** after **0** hours pumping **0 gpm**  
 Bore Hole Diameter **in.** to **0 ft.**, and **in.** to **0 ft.**  
 WELL WATER WAS: **DOMESTIC**  
 Was a chemical/bacteriological sample submitted to department? **No** ;  
 If yes, **no/day/yr** sample was submitted Water well disinfected? **Yes**

5 TYPE OF BLANK CASING USED: **RMP (SR)** CASING JOINTS:  
 Blank casing diameter **in.** to **0 ft.**, Dia **in.** to **0 ft.**, Dia **in.** to **0 ft.**  
 Casing height above land surface **0 in.**, weight **0 lbs/ft.** Wall thickness or gauge No.  
 TYPE OF SCREEN OR PERFORATION MATERIAL:  
 SCREEN OR PERFORATION OPENINGS ARE:

SCREEN PERFORATED INTERVALS: From **0 ft.** to **0 ft.**, From **0 ft.** to **0 ft.**  
 GRAVEL PACK INTERVALS: From **0 ft.** to **0 ft.**, From **0 ft.** to **0 ft.**

6 GROUT MATERIAL **BENTONITE**  
 Grout Intervals: From **0 ft.** to **0 ft.**, From **0 ft.** to **0 ft.**, From **0 ft.** to **0 ft.**  
 What is the nearest source of possible contamination: **NONE**  
 Direction from well? **How many feet? 0**

FROM	TO	LITHOLOGIC LOG	FROM	TO	PLUGGING INTERVALS
			0	5	CLAY
			5	10	BENTONITE GROUT
			10	120	CLAY
			120	150	BENTONITE GROUT
			150	205	FILL SAND
			0	0	
			0	0	
			0	0	
			0	0	

7 CONTRACTOR'S OR LANDOWNER'S CERTIFICATION: This water well was Plugged under my jurisdiction and was completed on (no/day/year) **03/22/95** and this record is true to the best of my knowledge and belief. Kansas Water Well Contractor's License No. **179** This Water Well Record was completed on (no/day/yr) **03/29/95** under the business name of **JOE'S WELL SERVICE, INC.** by (signature) *Judith Creek*