

1 LOCATION OF WATER WELL:	Fraction	Section Number	Township Number	Range Number
County: Ford	NE ¼ SE ¼ SE ¼	27	T 26 S	R 25 E/W

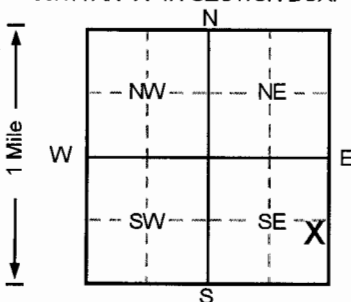
Distance and direction from nearest town or city street address of well if located within city?

1520 W. Wyatt Earp - Dodge City, KS2 WATER WELL OWNER: **Fina Oil and Chemical Company**RR#, St. Address, Box # : **P.O. Box 2159**City, State, ZIP Code : **Dallas, Texas 75221**

Board of Agriculture, Division of Water Resources

Application Number:

3 LOCATE WELL'S LOCATION WITH AN "X" IN SECTION BOX:

4 DEPTH OF COMPLETED WELL **35** ft. ELEVATION:

Depth(s) Groundwater Encountered 1. ft. 2. ft. 3. ft.

WELL'S STATIC WATER LEVEL ft. below land surface measured on mo/day/yr

Pump test data: Well water was **NA** ft. after hours pumping gpmEst. Yield .. **NA** .. gpm: Well water was ft. after hours pumping gpmBore Hole Diameter **8** in. to **37** ft., and in. to ft.

WELL WATER TO BE USED AS: 5 Public water supply 8 Air conditioning 11 Injection well

1 Domestic 3 Feedlot 6 Oil field water supply 9 Dewatering **12 Other (Specify below)**2 Irrigation 4 Industrial 7 Lawn and garden only 10 Monitoring well **Soil Vapor**Was a chemical/bacteriological sample submitted to Department? Yes.....No ☒; If yes, mo/day/yr sample was submittedWater Well Disinfected? Yes No ☒

5 TYPE OF BLANK CASING USED:

1 Steel

3 RMP (SR)

5 Wrought iron

8 Concrete tile

CASING JOINTS: Glued Clamped

2 PVC

4 ABS

6 Asbestos-Cement

9 Other (specify below)

Welded

7 Fiberglass

Threaded. ☒Blank casing diameter **2** in. to **25** ft., Dia in. to ft., Dia in. to ft.Casing height above land surface **0** in., weight lbs./ft. Wall thickness or gauge No. **Sch. 40**

TYPE OF SCREEN OR PERFORATION MATERIAL

1 Steel

3 Stainless steel

5 Fiberglass

7 PVC

10 Asbestos-cement

2 Brass

4 Galvanized steel

6 Concrete tile

8 RMP (SR)

11 Other (specify)

9 ABS

12 None used (open hole)

SCREEN OR PERFORATION OPENINGS ARE:

1 Continuous slot

3 Mill slot

5 Gauzed wrapped

8 Saw cut

11 None (open hole)

2 Louvered shutter

4 Key punched

6 Wire wrapped

9 Drilled holes

7 Torch cut

10 Other (specify)

SCREEN-PERFORATED INTERVALS: From **25** ft. to **35** ft., From ft. to ft.

From ft. to ft., From ft. to ft.

GRAVEL PACK INTERVALS: From **23** ft. to **35** ft., From ft. to ft.

From ft. to ft., From ft. to ft.

6 GROUT MATERIAL:

1 Neat cement

2 Cement grout**3** Bentonite

4 Other

Grout Intervals: From **0** ft. to **21** ft., From **21** ft. to **23** ft., From ft. to ft.

What is the nearest source of possible contamination:

1 Septic tank

4 Lateral lines

7 Pit privy

10 Livestock pens

14 Abandoned water well

2 Sewer lines

5 Cess pool

8 Sewage lagoon

11 Fuel storage

15 Oil well/Gas well

3 Watertight sewer lines

6 Seepage pit

9 Feedyard

12 Fertilizer storage

16 Other (specify below)

13 Insecticide storage

Former UST BasinDirection from well? **NW**How many feet? **158**

FROM	TO	LITHOLOGIC LOG	FROM	TO	PLUGGING INTERVALS
0	0.5	Silt, Light Brown			
0.5	2	Silt, Light Brown			
2	5	Clay, Medium Brown			
5	8	Clay, Dark Brown			
8	12	Clay, Light Orange Brown			
12	17	Clay, Medium Brown			
17	21	Clay, Dark Brown			
21	22	Clay, Light Gray			
22	24	Clay, Light Gray			
24	30	Sand, Medium to Dark Gray			
30	35	Sand, Medium to Dark Gray			
35	37	Sand, Light Gray Green			
					SVE22, Flushmount
					Project Name: Dahl - Fina #9472
					GeoCore # 310, KDHE # 01 029 574

7 CONTRACTOR'S OR LANDOWNER'S CERTIFICATION: This water well was **(1)** constructed, (2) reconstructed, or (3) plugged under my jurisdiction and was completed on (mo/day/year) **2/15/96** and this record is true to the best of my knowledge and belief.Kansas Water Well Contractor's License No. **527** This Water Well Record was completed on (mo/day/yr) **2/29/96**

under the business name of

GeoCore Services, Inc.

by (signature)

Dale A. Bell