


1 LOCATION OF WATER WELL: Fraction Section Number Township Number Range Number
 COUNTY: FORD SW 1/4 SW 1/4 SE 1/4 2 T 26 S R 25 W

Distance and direction from nearest town or city street address of well if located within city?
 FROM DODGE CITY - 1 1/2 MILES NORTH ON AVE. A

2 WATER WELL OWNER: HUGHES, CYD
 RR#, St. Address, Box #: 10494 105 ROAD Board of Agriculture, Division of Water Resources
 City, State, ZIP code: DODGE CITY, KS 67801- Application Number:

3 LOCATE WELL'S LOCATION WITH AN "X" IN SECTION BOX: 4 DEPTH OF COMPLETED WELL 159 ELEVATION: 0
 Depth(s) Groundwater Encountered 1. 0 ft. 2. 0 ft. 3. 0 ft.

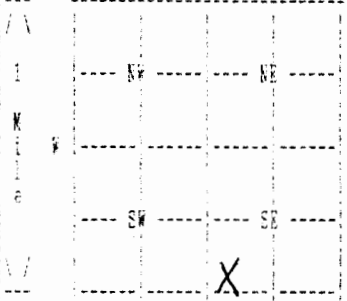

WELL'S STATIC WATER LEVEL 61 ft. below land surface measured on 06/08/96
 Pump test data: Well water was 0 ft. after 0 hours pumping 0 gpm

Estimated Yield 20 gpm; Well water was 0 ft. after 0 hours pumping 0 gpm

Bore Hole Diameter 10 in. to 159 ft., and in. to 0 ft.

WELL WATER TO BE USED AS: DOMESTIC

Was a chemical/bacteriological sample submitted to department? No;
 If yes, no/day/yr sample was submitted water well disinfected? Yes

5 TYPE OF BLANK CASING USED: PVC CASING JOINTS: GLUED
 Blank casing diameter 5 in. to 159 ft., Dia in. to 0 ft., Dia in. to 0 ft.
 Casing height above land surface 12 in., weight 200 lbs/ft. Wall thickness or gauge No. 21
 TYPE OF SCREEN OR PERFORATION MATERIAL: PVC
 SCREEN OR PERFORATION OPENINGS ARE: SAW CUT

SCREEN PERFORATED INTERVALS: From 116 ft. to 156 ft., From 0 ft. to 0 ft.
 From 0 ft. to 0 ft., From 0 ft. to 0 ft.
 GRAVEL PACK INTERVALS: From 30 ft. to 159 ft., From 0 ft. to 0 ft.
 From 0 ft. to 0 ft., From 0 ft. to 0 ft.

6 GROUT MATERIAL BERTONITE
 Grout intervals: From 0 ft. to 30 ft., From 0 ft. to 0 ft., From 0 ft. to 0 ft.
 What is the nearest source of possible contamination: ABANDONED WELL
 Direction from well? NORTH How many feet? 19

FROM	TO	LITHOLOGIC LOG	FROM	TO	PERFORATING INTERVALS
0	20	TOPSOIL CLAY			
20	40	CLAY CALACHIE SAND ROCK LAYER			
40	60	SAND ROCK FINE SAND			
60	80	FINE - MED SAND CLAY			
80	100	CLAY THIN ROCK LAYER			
100	120	ROCK LAYERS FINE - MED SAND			
120	140	FINE - MED SAND CLAY LAYERS			
140	160	FINE SAND CLAY THIN ROCK LAYER			
160	180	CLAY THIN ROCK LAYER BLUE SHALE			

7 CONTRACTOR'S OR LANDOWNER'S CERTIFICATION: This water well was constructed under my jurisdiction and was completed on (no/day/year) 06/10/96 and this record is true to the best of my knowledge and belief. I declare
 Water Well Contractor's License No. 179 This Water Well Record was completed on no/day/yr: 06/10/96
 under the business name of JOB'S WELL SERVICE, INC. by (signature) Judith Cuiet