


1 LOCATION OF WATER WELL: County: <b>FORD</b>	Fraction <b>NW 1/4 SW 1/4 SW 1/4</b>	Section Number <b>26</b>	Township Number <b>T 26 S</b>	Range Number <b>R 25 EW</b>
--	---	-----------------------------	----------------------------------	--------------------------------

Distance and direction from nearest town or city street address of well if located within city?

**1410 Wyatt Earp, Dodge City**

2 WATER WELL OWNER: RR#, St. Address, Box # : City, State, ZIP Code	<b>Jim Council</b> <b>1410 Wyatt Earp</b> <b>Dodge City, KS 67801</b>	Board of Agriculture, Division of Water Resources Application Number: <b>VEW-1</b>
---	---	--

3 LOCATE WELL'S LOCATION WITH AN "X" IN SECTION BOX:	4 DEPTH OF COMPLETED WELL: <b>45</b> ft. ELEVATION:
--	---

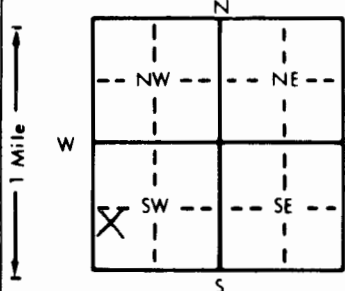

Depth(s) Groundwater Encountered 1. .... ft. 2. .... ft. 3. .... ft.

WELL'S STATIC WATER LEVEL **26.68** ft. below land surface measured on mo/day/yr

Pump test data: Well water was .... ft. after .... hours pumping .... gpm

Est. Yield .... gpm: Well water was .... ft. after .... hours pumping .... gpm

Bore Hole Diameter: **8** in. to **45** ft., and .... in. to .... ft.

WELL WATER TO BE USED AS: 5 Public water supply 8 Air conditioning 11 Injection well

1 Domestic 3 Feedlot 6 Oil field water supply 9 Dewatering 12 Other (Specify below)

2 Irrigation 4 Industrial 7 Lawn and garden only 10 Monitoring wellWas a chemical/bacteriological sample submitted to Department? Yes No X; If yes, mo/day/yr sample was submittedWater Well Disinfected? Yes No X

5 TYPE OF BLANK CASING USED:	5 Wrought iron	8 Concrete tile	CASING JOINTS: Glued .... Clamped ....
------------------------------	----------------	-----------------	--

1 Steel 3 RMP (SR) 6 Asbestos-Cement 9 Other (specify below) Welded ....

2 PVC 4 ABS 7 Fiberglass Threaded XBlank casing diameter **4** in. to **10** ft., Dia. .... in. to .... ft., Dia. .... in. to .... ft.Casing height above land surface **0** in., weight **2.071** lbs./ft. Wall thickness or gauge No. **237**TYPE OF SCREEN OR PERFORATION MATERIAL: 7 PVC 10 Asbestos-cement

1 Steel 3 Stainless steel 5 Fiberglass 8 RMP (SR) 11 Other (specify) ....

2 Brass 4 Galvanized steel 6 Concrete tile 9 ABS 12 None used (open hole)

SCREEN OR PERFORATION OPENINGS ARE: 5 Gauzed wrapped 8 Saw cut 11 None (open hole)

1 Continuous slot 3 Mill slot 6 Wire wrapped 9 Drilled holes

2 Louvered shutter 4 Key punched 7 Torch cut 10 Other (specify) ....

SCREEN-PERFORATED INTERVALS: From **10** ft. to **45** ft., From .... ft. to .... ft.

From .... ft. to .... ft., From .... ft. to .... ft.

GRAVEL PACK INTERVALS: From **8** ft. to **45** ft., From .... ft. to .... ft.

From .... ft. to .... ft., From .... ft. to .... ft.

6 GROUT MATERIAL:	1 Neat cement	2 <u>Cement grout</u>	3 <u>Bentonite</u>	4 Other
-------------------	---------------	-----------------------	--------------------	---------

Grout Intervals: From **0** ft. to **4** ft., From **4** ft. to **8** ft., From .... ft. to .... ft.

What is the nearest source of possible contamination: 10 Livestock pens 14 Abandoned water well

1 Septic tank 4 Lateral lines 7 Pit privy 11 Fuel storage 15 Oil well/Gas well

2 Sewer lines 5 Cess pool 8 Sewage lagoon 12 Fertilizer storage 16 Other (specify below)

3 Watertight sewer lines 6 Seepage pit 9 Feedyard 13 Insecticide storage **Contaminated site**

Direction from well? How many feet?

FROM	TO	LITHOLOGIC LOG	FROM	TO	PLUGGING INTERVALS
------	----	----------------	------	----	--------------------

**0** **5** **Concrete**

**23** **45** **Clay w/ silt**

**23** **45** **Sand, silt, & some gravel**

7 CONTRACTOR'S OR LANDOWNER'S CERTIFICATION: This water well was (1) <u>constructed</u> , (2) reconstructed, or (3) plugged under my jurisdiction and was completed on (mo/day/year) <b>8-6-97</b> and this record is true to the best of my knowledge and belief. Kansas
---

Water Well Contractor's License No. **554** This Water Well Record was completed on (mo/day/yr) **10-6-97**under the business name of **Woofter Pump & Well, Inc.** by (signature) **Jay C. Woofter**