

CORRECTION(S) TO WATER WELL RECORD (WWC-5)

(to rectify lacking or incorrect information)

County: Ford County

Location listed as:

Section-Township-Range: 35-T25S-R25W

Fraction (1/4 1/4 1/4): ~~NW NE NE~~ SW SE NE

Location changed to:

35-T26S-R25W

SE SW NE

Other changes: Initial statements: Set of monitoring wells for Fas Stop from
1993 are clearly in wrong place.

Changed to: T26S, fraction changed to match other monitoring wells

Comments: _____

verification method: WWCS database, MapQuest web site

initials: DAH date: June 9, 2005

submitted by: Kansas Geological Survey, Data Resources Library, 1930 Constant Ave., Lawrence, KS 66047-3726
to: Kansas Dept of Health & Environment, Bureau of Water, 1000 SW Jackson, Suite 420, Topeka, KS 66612-1367.


1 LOCATION OF WATER WELL: Fraction **SW¹/₄ SE ¹/₄ NE¹/₄** Section Number **35** Township Number **T 25 S** Range Number **R 25 E/W**
 County: **Ford**

Distance and direction from nearest town or city street address of well if located within city?

301 South Second Street, Dodge City, Kansas

2 WATER WELL OWNER: **Fas Stop**
 RR#, St. Address, Box # : **301 S. Second St.**
 City, State, ZIP Code : **Dodge City, Ks.**
 Board of Agriculture, Division of Water Resources
 Application Number: _____

3 LOCATE WELL'S LOCATION WITH AN "X" IN SECTION BOX:

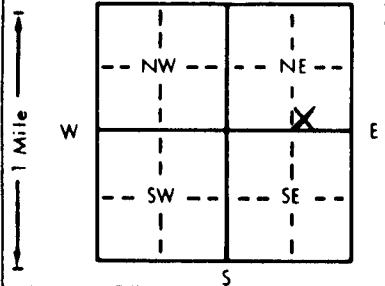

4 DEPTH OF COMPLETED WELL: **24** ft. ELEVATION: **NA**
 Depth(s) Groundwater Encountered 1. **20** ft. 2. _____ ft. 3. _____ ft.
 WELL'S STATIC WATER LEVEL: **17.48** ft. below land surface measured on mo/day/yr **11-30-93**
 Pump test data: Well water was _____ ft. after _____ hours pumping _____ gpm
 Est. Yield _____ gpm: Well water was _____ ft. after _____ hours pumping _____ gpm
 Bore Hole Diameter: **7.5/8** in. to **24** ft., and _____ in. to _____ ft.
 WELL WATER TO BE USED AS:
 5 Public water supply 8 Air conditioning 11 Injection well
 1 Domestic 3 Feedlot 6 Oil field water supply 9 Dewatering 12 Other (Specify below)
 2 Irrigation 4 Industrial 7 Lawn and garden only **10** Monitoring well _____
 Was a chemical/bacteriological sample submitted to Department? Yes _____ No **X** _____; If yes, mo/day/yr sample was submitted _____
 Water Well Disinfected? Yes _____ No **X** _____

5 TYPE OF BLANK CASING USED:
 1 Steel 3 RMP (SR) 5 Wrought iron 8 Concrete tile CASING JOINTS: Glued _____ Clamped _____
2 PVC 4 ABS 6 Asbestos-Cement 9 Other (specify below) Welded _____
 Blank casing diameter **2** in. to **14** ft., Dia _____ in. to _____ ft., Dia _____ in. to _____ ft.
 Casing height above land surface **0** in., weight _____ lbs./ft. Wall thickness or gauge No. **sch. 40**
 TYPE OF SCREEN OR PERFORATION MATERIAL:
 1 Steel 3 Stainless steel 5 Fiberglass **7** PVC 10 Asbestos-cement
 2 Brass 4 Galvanized steel 6 Concrete tile 8 RMP (SR) 11 Other (specify) _____
 9 ABS 12 None used (open hole)
 SCREEN OR PERFORATION OPENINGS ARE:
 1 Continuous slot **3** Mill slot 5 Gauzed wrapped 8 Saw cut 11 None (open hole)
 2 Louvered shutter 4 Key punched 6 Wire wrapped 9 Drilled holes
 7 Torch cut 10 Other (specify) _____
 SCREEN-PERFORATED INTERVALS: From _____ ft. to _____ ft., From _____ ft. to _____ ft.
 From _____ ft. to _____ ft., From _____ ft. to _____ ft.
 GRAVEL PACK INTERVALS: From **12** ft. to **24** ft., From _____ ft. to _____ ft.
 From _____ ft. to _____ ft., From _____ ft. to _____ ft.

6 GROUT MATERIAL: 1 Neat cement **2** Cement grout **3** Bentonite 4 Other _____
 Grout Intervals: From **0** ft. to **10** ft., From **10** ft. to **12** ft., From _____ ft. to _____ ft.
 What is the nearest source of possible contamination:
 1 Septic tank 4 Lateral lines 7 Pit privy **11** Fuel storage 10 Livestock pens 14 Abandoned water well
 2 Sewer lines 5 Cess pool 8 Sewage lagoon 12 Fertilizer storage 15 Oil well/Gas well
 3 Watertight sewer lines 6 Seepage pit 9 Feedyard 13 Insecticide storage 16 Other (specify below) _____
 Direction from well? **west** How many feet? **120**

FROM	TO	LITHOLOGIC LOG	FROM	TO	PLUGGING INTERVALS
0	6"	concrete			
6"	1'	cl, v drk brn, v slty			
1	5	snd, med-red brn, v slty, sl clayey, v f grnd			
5	10	snd, v f-med grnd, v slty, tr of grvl, well srted, lt gry			
10	18	snd, f-c grnd, sl-mod grvl, tr of rock, prly srted, lt-med gry			
18	22	snd, f-c, mod-v grvly, sl-mod rock, lt gry			
22	24	cl, lt brn, v slty, sl-mod f snd, tr of rock			
					FMW9-flush mount cover

7 CONTRACTOR'S OR LANDOWNER'S CERTIFICATION: This water well was **(1)** constructed, (2) reconstructed, or (3) plugged under my jurisdiction and was completed on (mo/day/year) **11-17-93** and this record is true to the best of my knowledge and belief. Kansas Water Well Contractor's License No. **527**. This Water Well Record was completed on (mo/day/yr) **12-14-93** under the business name of **GeoCore Services, Inc.** by (signature) *Dale G. Kelly*