

CORRECTION(S) TO WATER WELL RECORD (WWC-5)

(to rectify lacking or incorrect information)

County: Ford County

Location listed as:

Section-Township-Range: 35-T25S-R25W

Fraction (  $\frac{1}{4}$   $\frac{1}{4}$   $\frac{1}{4}$ ): ~~NW NE NE NE NE SE~~

Location changed to:

35-T26S-R25W

SE SW NE

Other changes: Initial statements:

Set of monitoring wells for Fas Stop from

1993 are clearly in wrong place.

Changed to:

T26S, fraction changed to match other monitoring wells

Comments:

verification method:

WWCS database, MapQuest web site

initials: DAH

date: June 9, 2005


submitted by: Kansas Geological Survey, Data Resources Library, 1930 Constant Ave., Lawrence, KS 66047-3726

to: Kansas Dept of Health & Environment, Bureau of Water, 1000 SW Jackson, Suite 420, Topeka, KS 66612-1367.

1 LOCATION OF WATER WELL: County: **Ford** Fraction: **NE 1/4 NE 1/4 SE 1/4** Section Number: **35** Township Number: **T 25 S** Range Number: **R 25 E** **EW**

Distance and direction from nearest town or city street address of well if located within city?  
**301 South Second Street, Dodge City, Kansas**

2 WATER WELL OWNER: **Fas Stop**  
 RR#, St. Address, Box #: **301 S. Second St.**  
 City, State, ZIP Code: **Dodge City, Ks.**  
 Board of Agriculture, Division of Water Resources  
 Application Number:

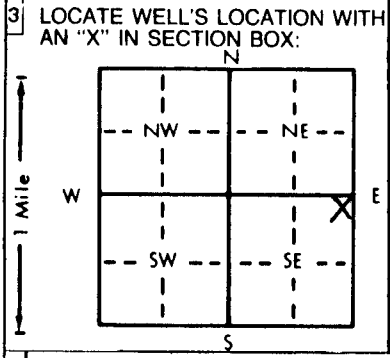

4 DEPTH OF COMPLETED WELL: **24** ft. ELEVATION: **NA**  
 Depth(s) Groundwater Encountered: 1. **20** ft. 2. ft. 3. ft.  
 WELL'S STATIC WATER LEVEL: **18.25** ft. below land surface measured on **11-30-93**  
 Pump test data: Well water was ft. after hours pumping gpm  
 Est. Yield gpm: Well water was ft. after hours pumping gpm  
 Bore Hole Diameter: **7.5/8** in. to **24** ft., and in. to ft.  
 WELL WATER TO BE USED AS:  
 5 Public water supply 8 Air conditioning 11 Injection well  
 1 Domestic 3 Feedlot 6 Oil field water supply 9 Dewatering 12 Other (Specify below)  
 2 Irrigation 4 Industrial 7 Lawn and garden only **10** Monitoring well  
 Was a chemical/bacteriological sample submitted to Department? Yes  No ; If yes, mo/day/yr sample was submitted  
 Water Well Disinfected? Yes  No

5 TYPE OF BLANK CASING USED:  
 1 Steel 3 RMP (SR) 5 Wrought iron 8 Concrete tile CASING JOINTS: Glued  Clamped   
 2 **PVC** 4 ABS 6 Asbestos-Cement 9 Other (specify below) Welded   
 7 Fiberglass Threaded   
 Blank casing diameter: **2** in. to **14** ft., Dia. in. to ft., Dia. in. to ft.  
 Casing height above land surface: **0** in., weight lbs./ft. Wall thickness or gauge No. **sch. 40**  
 TYPE OF SCREEN OR PERFORATION MATERIAL:  
 1 Steel 3 Stainless steel 5 Fiberglass **7** PVC 10 Asbestos-cement  
 2 Brass 4 Galvanized steel 6 Concrete tile 8 RMP (SR) 11 Other (specify)   
 12 None used (open hole)  
 SCREEN OR PERFORATION OPENINGS ARE:  
 1 Continuous slot 3 **Mill slot** 5 Gauzed wrapped 8 Saw cut 11 None (open hole)  
 2 Louvered shutter 4 Key punched 6 Wire wrapped 9 Drilled holes  
 7 Torch cut 10 Other (specify)   
 SCREEN-PERFORATED INTERVALS: From **14** ft. to **24** ft., From ft. to ft., From ft. to ft.  
 GRAVEL PACK INTERVALS: From **12** ft. to **24** ft., From ft. to ft., From ft. to ft.

6 GROUT MATERIAL: 1 Neat cement 2 **Cement grout** 3 **Bentonite** 4 Other   
 Grout Intervals: From **0** ft. to **10** ft., From **10** ft. to **12** ft., From ft. to ft.  
 What is the nearest source of possible contamination:  
 1 Septic tank 4 Lateral lines 7 Pit privy **11** Fuel storage 14 Abandoned water well  
 2 Sewer lines 5 Cess pool 8 Sewage lagoon 12 Fertilizer storage 15 Oil well/Gas well  
 3 Watertight sewer lines 6 Seepage pit 9 Feedyard 13 Insecticide storage 16 Other (specify below)   
 Direction from well? **northeast** How many feet? **700**

FROM	TO	LITHOLOGIC LOG	FROM	TO	PLUGGING INTERVALS
0	3'	cl, med-lt brn, v slty, mod snd, f-c grnd, org rich			
3	10	snd, v f-f grnd, tr of grvl, well srted, yell			
10	15	snd, f-c grnd, sl-mod grvl, tr of rock, yell-brn			
15	17	snd, v f-med grnd, tr of rock, well srted, yell-brn			
17	20	snd, f-c, sl-mod grvl, sl rock up to 1" in size, yell-brn			
20	24	snd, f-c, sl-mod grvl, tr of rock up to 1" in size, yell-brn			
					<b>FMW12-flush mount cover</b>

7 CONTRACTOR'S OR LANDOWNER'S CERTIFICATION: This water well was **(1)** constructed, (2) reconstructed, or (3) plugged under my jurisdiction and was completed on (mo/day/year) **11-18-93** and this record is true to the best of my knowledge and belief. Kansas Water Well Contractor's License No. **527** This Water Well Record was completed on (mo/day/yr) **12-14-93** under the business name of **GebCore Services, Inc.** by (signature) *Doherty*