

USE TYPEWRITER OR BALL POINT PEN-PRESS FIRMLY, PRINT CLEARLY.


WATER WELL RECORD
KSA 82a-1201-1215

Kansas Department of Health and Environment-Division of Environment
(Water well Contractors)
Topeka, Kansas 66620

BALL

1. Location of well: County **FORD** Fraction **NE 1/4 NE 1/4 NW 1/4** Section number **H-~~3~~** Township number **T 96 S R 25 E/W** Range number

2. Distance and direction from nearest town or city: **DODGE CITY - 2 NORTH 3 WEST 3/4 NORTH 1/3 EAST**
Street address of well location if in city:
3. Owner of well: **HAROLD ZIMMER**
R.R. or street: **DENVER COLO.**
City, state, zip code:

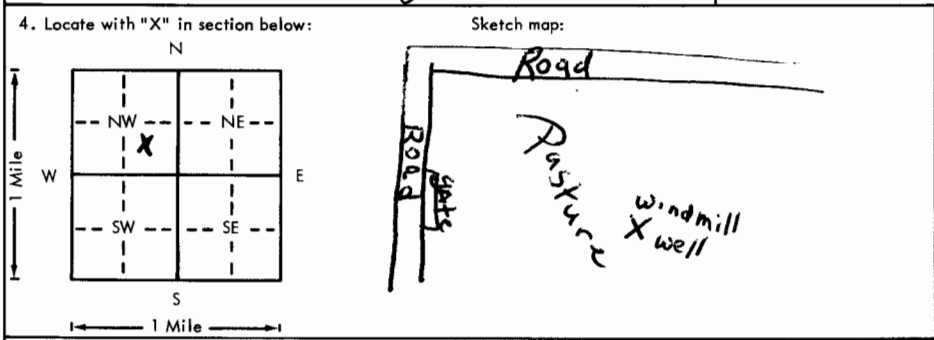

6. Bore hole dia. **9.75** in. Completion date **6-24-77**
Well depth **90** ft.
7. Cable tool Rotary Driven Dug
 Hollow rod Jetted Bored Reverse rotary
8. Use: Domestic Public supply Industry
 Irrigation Air conditioning Stock
 Lawn Oil field water Other
9. Casing: Material **PVC** Height **Above** or below
Threaded Welded **gl** Surface **1.8** in.
RMP PVC Weight **1.8** lbs./ft.
Dia. **5** in. to **90** ft. depth Wall Thickness: inches or
Dia. **0.250** in. to **0** ft. depth gage No.

5. Type and color of material	From	To
Surface	0	3
Sandy clay	3	15
Fine sand, sand rock and clay	15	45
Sand and gravel	45	75
Sand and sand rock	75	85
Yellow clay	(85)	90
(Use a second sheet if needed)		

10. Screen: Manufacturer's name **Jess and Lowell**
Type **RMP** Dia. **5 in.**
Slot/gauze **.06** Length **30-60** ft.
Set between **30** ft. and **90** ft.
Gravel pack **yes** Size range of material **1/4 - 1/8**
11. Static water level: **60** ft. below land surface Date **6-25-77** mo./day/yr.
12. Pumping level below land surfaces:
____ ft. after ____ hrs. pumping ____ g.p.m.
____ ft. after ____ hrs. pumping ____ g.p.m.
Estimated maximum yield ____ g.p.m.
13. Water sample submitted: ____ Yes No Date ____
14. Well head completion: **none**
____ Pitless adapter ____ Inches above grade
15. Well grouted? **yes**
With: Neat cement Bentonite Concrete
Depth: From **0** ft. to **13** ft.
16. Nearest source of possible contamination: **nc**
ft. ____ Direction ____ Type ____
Well disinfected upon completion? ____ Yes No
17. Pump: Not installed
Manufacturer's name ____
Model number ____ HP ____ Volts ____
Length of drop pipe ____ ft. capacity ____ g.p.m.
Type:
 Submersible Turbine
 Jet Reciprocating
 Centrifugal Other

18. Elevation: Topography: Hill
 Slope
 Upland
 Valley
19. Remarks: **2551**
7010
1466

20. Water well contractor's certification:
This well was drilled under my jurisdiction and this report is true to the best of my knowledge and belief.
Hodde Drilling Co. 302
Business name License No. **RR 1 Dodge City, Kans.**
Address
Signed **Walter Hodde** Date **7-16-77**
Authorized representative

2551-7-14 NE 1/4 NW 1/4