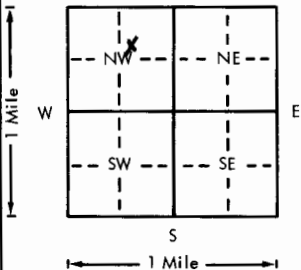


USE TYPEWRITER OR BALL  
POINT PEN-PRESS FIRMLY,  
PRINT CLEARLY.

WATER WELL RECORD  
KSA 82a-1201-1215

Kansas Department of Health and  
Environment-Division of Environment  
(Water well Contractors)  
Topeka, Kansas 66620

BAC

1. Location of well:		County <b>Ford</b>	Fraction <b>SW 1/4 NE 1/4 NW 1/4</b>	Section number <b>9</b>	Township number <b>T 26 S R 25 E/W</b>	Range number
2. Distance and direction from nearest town or city: <b>1/4 south Highway 56</b>			3. Owner of well: <b>Bob Elder</b> R.R. or street: <b>1202 West Trail</b> City, state, zip code: <b>Dodge City, Ks 67801</b>			
4. Locate with "X" in section below: 		Sketch map: <b>X well</b> <b>House</b> <b>X septic</b>		6. Bore hole dia. <b>8</b> in. Completion date <b>9-7-78</b> Well depth <b>140</b> ft.		
5. Type and color of material		From	To	7. <input checked="" type="checkbox"/> Cable tool <input checked="" type="checkbox"/> Rotary <input type="checkbox"/> Driven <input type="checkbox"/> Dug <input type="checkbox"/> Hollow rod <input type="checkbox"/> Jetted <input type="checkbox"/> Bored <input type="checkbox"/> Reverse rotary		
<b>Topsoil</b>		<b>0</b>	<b>3</b>	8. Use: <input checked="" type="checkbox"/> Domestic <input type="checkbox"/> Public supply <input type="checkbox"/> Industry <input type="checkbox"/> Irrigation <input type="checkbox"/> Air conditioning <input type="checkbox"/> Stock <input type="checkbox"/> Lawn <input type="checkbox"/> Oil field water <input type="checkbox"/> Other		
<b>Clay</b>		<b>3</b>	<b>25</b>	9. Casing: Material <b>Plastic</b> Height: Above or below Threaded <input type="checkbox"/> Welded <input type="checkbox"/> Surface <b>18</b> in. RMP <input type="checkbox"/> PVC <b>Glue</b> Weight <input type="checkbox"/> lbs./ft. Dia. <b>5</b> in. to <b>120</b> ft. depth Wall Thickness: inches or Dia. <input type="checkbox"/> in. to <input type="checkbox"/> ft. depth gage No. <b>250</b>		
<b>Sandy clay</b>		<b>25</b>	<b>45</b>	10. Screen: Manufacturer's name <b>Jess &amp; Lowell</b> Type <b>Plastic</b> Dia. <b>5</b> in. Slot <b>1/4</b> Length <b>20</b> ft. Set between <b>120</b> ft. and <b>140</b> ft. Gravel pack? <b>yes</b> Size range of material <b>1/4</b>		
<b>Gravel</b>		<b>45</b>	<b>140</b>	11. Static water level: <b>N/A</b> mo./day/yr. <b>87</b> ft. below land surface Date <b>9/7/78</b>		
				12. Pumping level below land surfaces: <b>N/A</b> ft. after hrs. pumping g.p.m. ft. after hrs. pumping g.p.m. Estimated maximum yield g.p.m.		
				13. Water sample submitted: mo./day/yr. Yes <input checked="" type="checkbox"/> No <input type="checkbox"/> Date		
				14. Well head completion: <input checked="" type="checkbox"/> Pitless adapter <b>18</b> inches above grade		
				15. Well grouted? <b>yes</b> With: <input checked="" type="checkbox"/> Neat cement <input type="checkbox"/> Bentonite <input type="checkbox"/> Concrete Depth: From <b>0</b> ft. to <b>20</b> ft.		
				16. Nearest source of possible contamination: <b>Septic</b> ft. <b>150</b> Direction <b>S</b> Type <b>Septic</b> Well disinfected upon completion? <input checked="" type="checkbox"/> Yes <input type="checkbox"/> No		
				17. Pump: Not installed Manufacturer's name <b>Sta Rite</b> Model number <b>20P40S2</b> HP <b>1-1/2</b> Volts Length of drop pipe <b>105</b> ft. capacity g.p.m. Type: <input checked="" type="checkbox"/> Submersible <input type="checkbox"/> Turbine <input type="checkbox"/> Jet <input type="checkbox"/> Reciprocating <input type="checkbox"/> Centrifugal <input type="checkbox"/> Other		
18. Elevation:		19. Remarks:		20. Water well contractor's certification: This well was drilled under my jurisdiction and this report is true to the best of my knowledge and belief. <b>Cragg Well Drilling</b> <b>111</b> Business name License No. Address <b>Dodge City, Ks 67801</b> Signed <b>[Signature]</b> Date <b>9/11/78</b> Authorized representative		

## CORRECTION(S) TO WATER WELL RECORD (WWC-5)

(to rectify lacking or incorrect information)

County: Ford

Location listed as:

Section-Township-Range: 9-T26S-R25WFraction (  $\frac{1}{4}$   $\frac{1}{4}$   $\frac{1}{4}$  ): SW NE NW

Location changed to:

9-T27S-R25WC SW NW

Other changes: Initial statements: \_\_\_\_\_

Changed to: \_\_\_\_\_

Comments: Based on directions, houses in section, current addresses, and  
so on, this well was moved.

verification method: \_\_\_\_\_

initials: DAH date: Oct. 17, 2007submitted by: Kansas Geological Survey, Data Resources Library, 1930 Constant Ave., Lawrence, KS 66047-3726  
to: Kansas Dept of Health & Environment, Bureau of Water, 1000 SW Jackson, Suite 420, Topeka, KS 66612-1367.