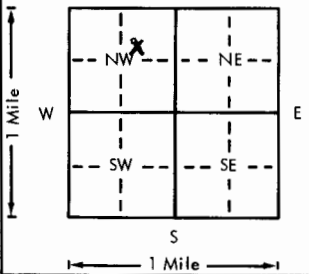


USE TYPEWRITER OR BALL
POINT PEN-PRESS FIRMLY,
PRINT CLEARLY.

WATER WELL RECORD
KSA 82a-1201-1215

Kansas Department of Health and
Environment-Division of Environment
(Water well Contractors)
Topeka, Kansas 66620

1. Location of well:		County Ford	Fraction SW 1/4 NE 1/4 NW 1/4	Section number 9	Township number T 26 S	Range number R 25 E/W
2. Distance and direction from nearest town or city: 1 mile west Street address of well location if in city: 1/4 mile south Highway 56				3. Owner of well: Johnny Flowers R.R. or street: 1700 West Park St. City, state, zip code: Dodge City, Ks		
4. Locate with "X" in section below:  Sketch map: X well 100' X septic				6. Bore hole dia. 8 in. Completion date 9-1-78 Well depth 160 ft.		
5. Type and color of material				7. <input checked="" type="checkbox"/> Cable tool <input checked="" type="checkbox"/> Rotary <input type="checkbox"/> Driven <input type="checkbox"/> Dug <input type="checkbox"/> Hollow rod <input type="checkbox"/> Jetted <input type="checkbox"/> Bored <input type="checkbox"/> Reverse rotary		
				8. Use: <input checked="" type="checkbox"/> Domestic <input type="checkbox"/> Public supply <input type="checkbox"/> Industry <input type="checkbox"/> Irrigation <input type="checkbox"/> Air conditioning <input type="checkbox"/> Stock <input type="checkbox"/> Lawn <input type="checkbox"/> Oil field water <input type="checkbox"/> Other		
				9. Casing: Material Plastic Height: Above or below 18 Threaded <input type="checkbox"/> Welded <input type="checkbox"/> Surface 18 in. RMP <input type="checkbox"/> PVC Glue Weight <input type="checkbox"/> lbs./ft. Dia. 5 in. to 120 depth Wall Thickness: inches or Dia. <input type="checkbox"/> in. to <input type="checkbox"/> ft. depth gage No. 250		
				10. Screen: Manufacturer's name Jess & Lowell Type Plastic Dia. 5" Slot 1/4 Length 30' Set between 130 ft. and 160 ft. Gravel pack? yes Size range of material 1/4		
				11. Static water level: N/A mo./day/yr. 87 ft. below land surface Date 9/1/78		
				12. Pumping level below land surfaces: N/A ____ ft. after ____ hrs. pumping ____ g.p.m. ____ ft. after ____ hrs. pumping ____ g.p.m. Estimated maximum yield ____ g.p.m.		
				13. Water sample submitted: ____ mo./day/yr. Yes <input checked="" type="checkbox"/> No <input type="checkbox"/> Date ____		
				14. Well head completion: <input checked="" type="checkbox"/> Pitless adapter 18 inches above grade		
				15. Well grouted? yes With: <input checked="" type="checkbox"/> Neat cement <input type="checkbox"/> Bentonite <input type="checkbox"/> Concrete Depth: From 0 ft. to 20 ft.		
				16. Nearest source of possible contamination: ft. 100 Direction E Type septic Well disinfected upon completion? <input checked="" type="checkbox"/> Yes <input type="checkbox"/> No		
				17. Pump: <input checked="" type="checkbox"/> Not installed Manufacturer's name ____ Model number ____ HP ____ Volts ____ Length of drop pipe ____ ft. capacity ____ g.p.m. Type: <input type="checkbox"/> Submersible <input type="checkbox"/> Turbine <input type="checkbox"/> Jet <input type="checkbox"/> Reciprocating <input type="checkbox"/> Centrifugal <input type="checkbox"/> Other		
(Use a second sheet if needed)						
18. Elevation:		19. Remarks: 2591 160 1731				
Topography: <input checked="" type="checkbox"/> Hill <input checked="" type="checkbox"/> Slope <input type="checkbox"/> Upland <input type="checkbox"/> Valley		20. Water well contractor's certification: This well was drilled under my jurisdiction and this report is true to the best of my knowledge and belief. Cragg Well Drilling 111 Business name License No. Address Dodge City, Ks 67801 Signed Ray Phoe Date 9/1/78 Authorized representative				

CORRECTION(S) TO WATER WELL RECORD (WWC-5)

(to rectify lacking or incorrect information)

County: Fond

Location listed as:

Section-Township-Range: 9-T26S-R25WFraction ($\frac{1}{4}$ $\frac{1}{4}$ $\frac{1}{4}$): SW NE NW

Location changed to:

9-T27S-R25WSW SW NE NW

Other changes: Initial statements: _____

Changed to: _____

Comments: Based on directions, houses in section, current addresses,
and so on, this well was moved.

verification method: _____

initials: DAH date: Oct 17, 2007