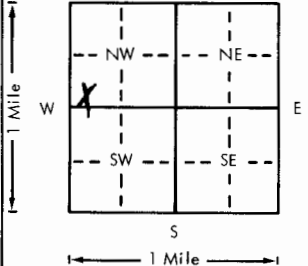


USE TYPEWRITER OR BALL
POINT PEN-PRESS FIRMLY,
PRINT CLEARLY.

WATER WELL RECORD
KSA 82a-1201-1215

Kansas Department of Health and
Environment-Division of Environment
(Water well Contractors)
Topeka, Kansas 66620

1. Location of well:		County Ford	Fraction SW 1/4 SW 1/4 NW 1/4	Section number 12	Township number T 26 S R 25 E/W	Range number
2. Distance and direction from nearest town or city: 1 mile North of Dodge City, Kansas 67801 on highway Ave. 1 Street address of well location if in city:			3. Owner of well: Condletree Realty R.R. or street: % Don Zimmer City, state, zip code: Dodge City, Kansas 67801			
4. Locate with "X" in section below: N W E S 1 Mile		Sketch map:		6. Bore hole dia. 8 in. Completion date Well depth 185 ft. 12-12-78		
		7. Cable tool <input checked="" type="checkbox"/> Rotary <input type="checkbox"/> Driven <input type="checkbox"/> Dug <input type="checkbox"/> Hollow rod <input type="checkbox"/> Jetted <input type="checkbox"/> Bored <input type="checkbox"/> Reverse rotary		8. Use: <input checked="" type="checkbox"/> Domestic <input type="checkbox"/> Public supply <input type="checkbox"/> Industry <input type="checkbox"/> Irrigation <input type="checkbox"/> Air conditioning <input type="checkbox"/> Stock <input type="checkbox"/> Lawn <input type="checkbox"/> Oil field water <input type="checkbox"/> Other		
		9. Casing: Material RMP Height: Above XXXX Threaded <input type="checkbox"/> Welded <input type="checkbox"/> Surface 12 in. RMP <input checked="" type="checkbox"/> PVC <input type="checkbox"/> Weight XXXX lbs./ft. Dia. 5 in. to 185 ft. depth Wall Thickness: inches or Dia. 5 in. to 185 ft. depth gage No. 250		10. Screen: Manufacturer's name Jess & Lowell Type RMP Dia. 5" Slot/gauge 1/8" Length 20 ft. Set between 140 ft. and 180 ft. Gravel pack? <input checked="" type="checkbox"/> Size range of material 1/4"		
		11. Static water level: 280 ft. below land surface Date 12-12-78		12. Pumping level below land surfaces: 85 ft. after 1 hrs. pumping 15 g.p.m. ft. after 1 hrs. pumping 15 g.p.m. Estimated maximum yield 25 g.p.m.		
		13. Water sample submitted: Yes <input checked="" type="checkbox"/> No <input type="checkbox"/> Date		14. Well head completion: none <input checked="" type="checkbox"/> Pitless adapter 12 inches above grade		
5. Type and color of material		From	To	15. Well grouted? yes With: <input checked="" type="checkbox"/> Neat cement <input type="checkbox"/> Bentonite <input type="checkbox"/> Concrete Depth: From 7 ft. to 20 ft.		
Top soil & clay		0	15	16. Nearest source of possible contamination: none ft. Direction Type Well disinfected upon completion? <input checked="" type="checkbox"/> Yes <input type="checkbox"/> No		
Clay		15	45	17. Pump: Installed yes <input checked="" type="checkbox"/> No <input type="checkbox"/> Installed 1979 Manufacturer's name Goulds Model number 10PJ10 HP 1 Volts 230 Length of drop pipe 167 ft. capacity 10 g.p.m. Type: <input checked="" type="checkbox"/> Submersible <input type="checkbox"/> Turbine <input type="checkbox"/> Jet <input type="checkbox"/> Reciprocating <input type="checkbox"/> Centrifugal <input type="checkbox"/> Other		
Clay & Medium sand		45	60	20. Water well contractor's certification: This well was drilled under my jurisdiction and this report is true to the best of my knowledge and belief. Joe's Well Service 179 Business name License No. Address Box 174 Cimarron, Ks. Signed Larry Crick 12-28-78 Authorized representative Date		
Medium sand & clay		60	75			
Clay		75	90			
Clay & fine sand layers		90	135			
Fine to medium sand		135	150			
Fine to medium sand & clay (4 ft.)		150	165			
Fine to medium sand & clay layers		165	180			
Clay & blue shale		180	195			
(Use a second sheet if needed)						
18. Elevation:		19. Remarks: new building site. The well is capped off will be finished at a later date. Finished on Sept. 24, 1979 2554				
Topography: <input type="checkbox"/> Hill <input checked="" type="checkbox"/> Slope <input type="checkbox"/> Upland <input type="checkbox"/> Valley						

26 250 12 2554 1/4 1/4 1/4