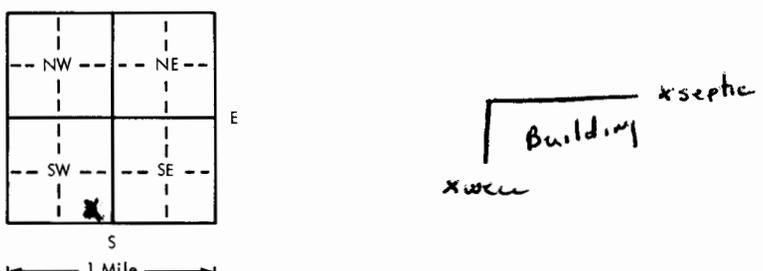


USE TYPEWRITER OR BALL POINT PEN—PRESS FIRMLY, PRINT CLEARLY.

WATER WELL RECORD  
KSA 82a-1201-1215

Kansas Department of Health and Environment—Division of Environment (Water well Contractors)  
Topeka, Kansas 66620

CDD

1. Location of well:	County <b>Ford</b>	Fraction <b>SE 1/4 SE 1/4 SW 1/4</b>	Section number <b>13</b>	Township number T <b>26</b> S	Range number R <b>25</b> E/W
2. Distance and direction from nearest town or city: Street address of well location if in city:			3. Owner of well: <b>Larry Arbogast</b> R.R. or street: <b>2408 Melencamp</b> City, state, zip code: <b>Dodge City, Ks 67801</b>		
4. Locate with "X" in section below: N W E S 1 Mile			Sketch map: 		
5. Type and color of material			From	To	6. Bore hole dia: <u>8</u> in. Completion date: <u>9-13-78</u> Well depth <u>240</u> ft.
Topsoil			0	3	7. Cable tool <input checked="" type="checkbox"/> Rotary <input type="checkbox"/> Driven <input type="checkbox"/> Dug <input type="checkbox"/> Hollow rod <input type="checkbox"/> Jetted <input type="checkbox"/> Bored <input type="checkbox"/> Reverse rotary
Clay			3	100	8. Use: <input checked="" type="checkbox"/> Domestic <input type="checkbox"/> Public supply <input type="checkbox"/> Industry <input type="checkbox"/> Irrigation <input type="checkbox"/> Air conditioning <input type="checkbox"/> Stock <input type="checkbox"/> Lawn <input type="checkbox"/> Oil field water <input type="checkbox"/> Other
Gravel			100	110	9. Casing: Material <u>Plastic</u> Height: Above or below Threaded <input type="checkbox"/> Welded <input type="checkbox"/> Surface <u>18</u> in. RMP <input type="checkbox"/> PVC <u>Glue</u> Weight _____ lbs./ft. Dia. <u>5</u> in. <u>220</u> ft. depth Wall Thickness: inches or Dia. _____ in. to _____ ft. depth gage No. <u>250</u>
Clay			110	180	10. Screen: Manufacturer's name _____ <u>Jess &amp; Lowell</u> Type <u>Plastic</u> Dia. <u>5"</u> Slot/gauge <u>1/4</u> Length <u>20'</u> Set between <u>220</u> ft. and <u>240</u> ft. _____ ft. and _____ ft. Gravel pack? <u>Yes</u> Size range of material <u>1/4</u>
Gravel			180	240	11. Static water level: <del>***</del> _____ mo./day/yr. <u>130</u> ft. below land surface Date <u>9.13.78</u>
BRCCV 240 130					12. Pumping level below land surfaces: _____ ft. after _____ hrs. pumping <u>N/A</u> g.p.m. _____ ft. after _____ hrs. pumping _____ g.p.m. Estimated maximum yield _____ g.p.m.
110' sat 11.6					13. Water sample submitted: _____ mo./day/yr. <input checked="" type="checkbox"/> Yes <input type="checkbox"/> No Date _____
m of					14. Well head completion: <input checked="" type="checkbox"/> Pitless <del>unit</del> <u>unit</u> _____ inches above grade
					15. Well grouted? <u>yes</u> With: <input checked="" type="checkbox"/> Neat cement <input type="checkbox"/> Bentonite <input type="checkbox"/> Concrete Depth: From <u>0</u> ft. to <u>20</u> ft.
					16. Nearest source of possible contamination: ft. <u>100</u> Direction <u>S</u> Type <u>septic</u> Well disinfected upon completion? <input checked="" type="checkbox"/> Yes <input type="checkbox"/> No
					17. Pump: _____ Not installed Manufacturer's name <u>Dempster</u> Model number <u>HF375S2</u> HP <u>3/4</u> Volts _____ Length of drop pipe <u>189</u> ft. capacity _____ g.p.m. Type: <input checked="" type="checkbox"/> Submersible <input type="checkbox"/> Turbine <input type="checkbox"/> Jet <input type="checkbox"/> Reciprocating <input type="checkbox"/> Centrifugal <input type="checkbox"/> Other
(Use a second sheet if needed)					
18. Elevation:	19. Remarks:		20. Water well contractor's certification: This well was drilled under my jurisdiction and this report is true to the best of my knowledge and belief. <u>Cragg Well Drilling 111</u> Business name License No. _____ Address <u>Dodge City, Ks 67801</u> Signed <u>Larry Arbogast</u> Date <u>9.13.78</u> Authorized representative		
Topography: <input type="checkbox"/> Hill <input checked="" type="checkbox"/> Slope <input type="checkbox"/> Upland <input type="checkbox"/> Valley	<u>2586</u> <u>240</u> <u>2346</u>				

240 2586 13 S E S E S W 1/4 1/4 1/4