

USE TYPEWRITER OR BALL POINT PEN-PRESS FIRMLY, PRINT CLEARLY.

WATER WELL RECORD  
KSA 82a-1201-1215

T R EW sec 1/4 1/4 1/4 No.


Kansas State Dept. Of Health  
(Water Well Contractors)  
Forbes-Bldg. 740  
Topeka, Kansas 66620

WR1611

DDD

1 Location of well: County FORD Township name Dodge Fraction 2 ACRES SE 1/4 SE 1/4 SE 1/4 Section number 13 Town number 26 Range number 25

Distance and direction from nearest town or city: 1 mile N Dodge 3 Owner of well: ROD TORREY  
Street address of well location if in city: Address: Box 661, Dodge City KS

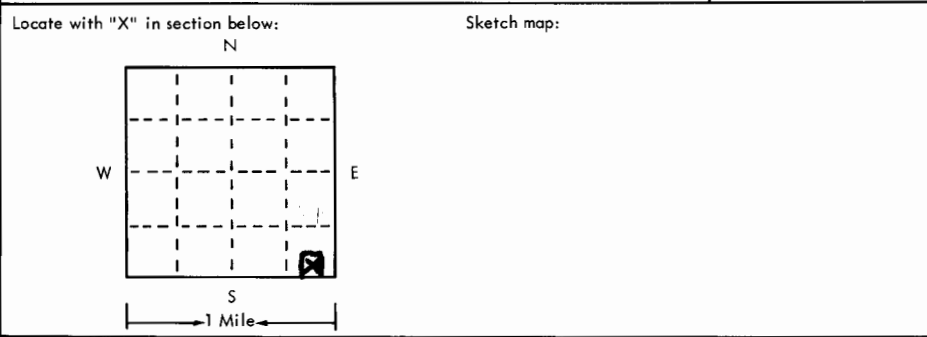

4 Well depth: 210 ft. Date of completion Sept 27 75  
Well diameter 8 in.

5  Cable tool  Rotary  Driven  Dug  
 Hollow rod  Jetted  Bored  Reverse rotary

6 Use:  Domestic  Public supply  Industry  
 Irrigation  Air conditioning  Commercial  
 Test well

7 Casing: Material PVC Height: above below  
Threaded  Welded  Surface 20 in.  
Diam. 6 1/2 in. Weight 125 lbs./ft.  
5 in. to 210 ft. depth Drive shoe?  Yes  No  
\_\_\_ in. to \_\_\_ ft. depth

2	Type and color of material	From	To
	CLAY	0	98
	SAND	98	110
	CLAY	110	170
	GRAVEL	170	204
	CLAY	204	210
	BRICK 204'		
	120 8' of sand thick		
	14' of		
	(use a second sheet if needed)		

8 Screen:  
Manufacturer Jess + Lowell  
Type PVC Dia. 5  
Slo gauze 11 1/2 Length 3  
Set between 180 ft. and 210 ft.  
Fittings:  
Gravel pack  Yes  No Size range of material 1/8

9 Static water level:  
180 ft. below land surface Date 8 Sept 75

10 Pumping level below land surfaces: N/A  
\_\_\_ ft. after \_\_\_ hrs. pumping \_\_\_ g.p.m.  
\_\_\_ ft. after \_\_\_ hrs. pumping \_\_\_ g.p.m.  
Estimated maximum yield \_\_\_ g.p.m.

11 Water sample submitted:  
 Yes  No Date \_\_\_

12 Well head completion:  
 Pitless adapter 20 inches above grade

13 Well grouted?  Yes  No  
 Neat cement  Bentonite   
Depth: From 3 ft. to 13 ft.

14 Nearest source of possible contamination:  
ft. 150 Direction South Type Sanitary  
Well disinfected upon completion?  Yes  No

15 Pump:  
 Not installed  
Manufacturer's name Reo A  
Model number FD10810 HP 2 Volts 230  
Length of drop pipe 189 ft. capacity 9000 g.p.m.  
Type:  
 Submersible  Turbine  
 Jet  Reciprocating  
 Centrifugal  Other

16 Remarks: elevation

Topography:  
 Hill  
 Slope  
 Upland  
 Valley

1090

2550  
204  
246

17 Water well contractor's certification:  
This well was drilled under my jurisdiction and this report is true to the best of my knowledge and belief.  
CRAGG Well Drilling III  
Business name License No. R+1 DCK  
Address Raymond  
Signed Raymond Date 8 Sept 75  
Authorized representative