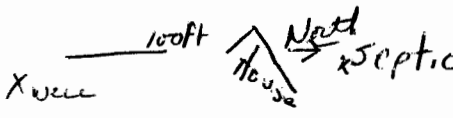


USE TYPEWRITER OR BALL POINT PEN-PRESS FIRMLY, PRINT CLEARLY.

WATER WELL RECORD
KSA 82a-1201-1215

Kansas Department of Health and Environment-Division of Environment
(Water well Contractors)
Topeka, Kansas 66620

WDT

1. Location of well:	County Ford	Fraction NW 1/4 SE 1/4 SE 1/4	Section number 13	Township number T 26	Range number S R 25 E 10
2. Distance and direction from nearest town or city: Street address of well location if in city:		1 Mile north Highway 50 Bypass		3. Owner of well: Kelly Dowling R.R. or street: RR 3 City, state, zip code: Dodge City, Ks 67801	
4. Locate with "X" in section below: N W E S 1 Mile		Sketch map: 		6. Bore hole dia. <u>8</u> in. Completion date _____ Well depth <u>200</u> ft. <u>7-27-77</u>	
5. Type and color of material		From	To	7. Cable tool <input checked="" type="checkbox"/> Rotary <input type="checkbox"/> Driven <input type="checkbox"/> Dug <input type="checkbox"/> Hollow rod <input type="checkbox"/> Jetted <input type="checkbox"/> Bored <input type="checkbox"/> Reverse rotary	
Topsoil		0	3	8. Use: <input checked="" type="checkbox"/> Domestic <input type="checkbox"/> Public supply <input type="checkbox"/> Industry <input type="checkbox"/> Irrigation <input type="checkbox"/> Air conditioning <input type="checkbox"/> Stock <input type="checkbox"/> Lawn <input type="checkbox"/> Oil field water <input type="checkbox"/> Other	
Clay		3	60	9. Casing: Material <u>Plastic</u> Weight: Above or below Threaded <input type="checkbox"/> Welded <input type="checkbox"/> Surface <u>7/8</u> in. RMP <u>PVC/6 in</u> Weight <u>250</u> lbs./ft. Dia. <u>5</u> in. to <u>200</u> ft. depth Wall Thickness: inches or Dia. _____ in. to _____ ft. depth gage No. <u>250</u>	
Sand & Rock		60	90	10. Screen: Manufacturer's name <u>Jess & Lowell</u> Type <u>Plastic</u> Dia. <u>5"</u> Slot/gauge <u>1/16</u> Length <u>30'</u> Set between <u>170</u> ft. and <u>200</u> ft. Gravel pack? <u>yes</u> Size range of material <u>4</u>	
Gravel		90	110	11. Static water level: _____ mo./day/yr. <u>100</u> ft. below land surface Date <u>7-27-77</u>	
Clay		110	115	12. Pumping level below land surfaces: <u>NIC</u> _____ ft. after _____ hrs. pumping _____ g.p.m. _____ ft. after _____ hrs. pumping _____ g.p.m. Estimated maximum yield _____ g.p.m.	
Gravel		115	200	13. Water sample submitted: _____ mo./day/yr. Yes <input checked="" type="checkbox"/> No <input type="checkbox"/> Date _____	
Clay		200	—	14. Well head completion: <input checked="" type="checkbox"/> Pitless adapter <u>16</u> inches above grade	
				15. Well grouted? <u>yes</u> With: <input checked="" type="checkbox"/> Neat cement <input type="checkbox"/> Bentonite <input type="checkbox"/> Concrete Depth: From <u>3</u> ft. to <u>20</u> ft.	
				16. Nearest source of possible contamination: ft. <u>100</u> Direction <u>N</u> Type <u>septic</u> Well disinfected upon completion? <input checked="" type="checkbox"/> Yes <input type="checkbox"/> No	
				17. Pump: Not installed Manufacturer's name <u>Dempster</u> Model number <u>HP3-150 SAP</u> <u>1 1/2</u> Volts _____ Length of drop pipe <u>168</u> ft. capacity _____ g.p.m. Type: <input checked="" type="checkbox"/> Submersible <input type="checkbox"/> Turbine <input type="checkbox"/> Jet <input type="checkbox"/> Reciprocating <input type="checkbox"/> Centrifugal <input type="checkbox"/> Other	
18. Elevation:		(Use a second sheet if needed)		20. Water well contractor's certification: This well was drilled under my jurisdiction and this report is true to the best of my knowledge and belief. Cragg Well Drilling 111 Business name License No. Address <u>1308 So Second Dodge City, Ks</u> Signed <u>Kelly Dowling</u> Date _____ Authorized representative	
19. Remarks: Topography: <input type="checkbox"/> Hill <input checked="" type="checkbox"/> Slope <input type="checkbox"/> Upland <input type="checkbox"/> Valley					

26 250 13 NW SE