


USE TYPEWRITER OR BALL POINT PEN-PRESS FIRMLY, PRINT CLEARLY.

WATER WELL RECORD
KSA 82a-1201-1215

Kansas Department of Health and Environment-Division of Environment (Water well Contractors)
Topeka, Kansas 66620

1. Location of well: County **Ford** Fraction **SW 1/4 NW 1/4 SE 1/4** Section number **13** Township number **T 26 S R 25 E/W**

2. Distance and direction from nearest town or city: **1/2 E on U.S. 50 Bypass, 1/4 N. Dodge City**
3. Owner of well: **Don Kleison**
R.R. or street: **RFD 2**
City, state, zip code: **Dodge City, Kansas 67801**

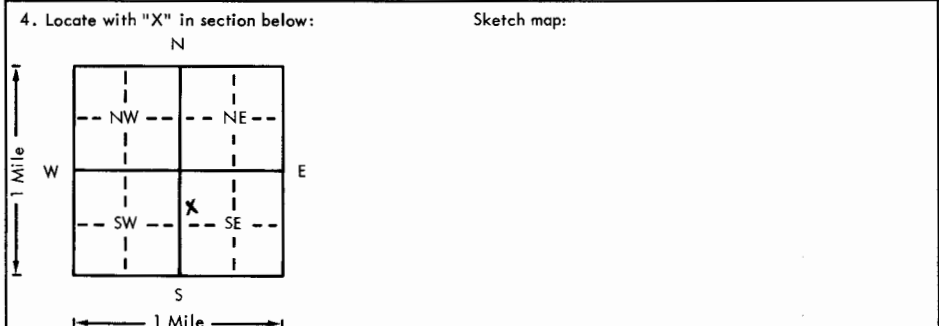

6. Bore hole dia. **9 7/8** in. Completion date _____
Well depth **225** ft. **3-12-79**
7. Cable tool Rotary Driven Dug
 Hollow rod Jetted Bored Reverse rotary
8. Use: Domestic Public supply Industry
 Irrigation Air conditioning Stock
 Lawn Oil field water Other
9. Casing: Material **PVC** Height: Above or below _____
Threaded Welded Surface **12** in.
RMP _____ PVC Weight **2.8** lbs./ft.
Dia. **5** in. to **225** ft. depth Wall thickness _____ inches or _____ gage No. _____
Dia. _____ in. to _____ ft. depth

5. Type and color of material

	From	To
Top Soil	0	7
Clay	7	30
Fine sand with limestone	30	84
Fine Sand with clay and limestone streaks	84	225
Shale	225	228
<i>BRock 225</i>		
<i>100</i>		
<i>125 sat. brick</i>		

10. Screen: Manufacturer's name _____
Pumpco
Type **PVC** Dia. **5"**
Slot/gauze **fine** Length **60'**
Set between **165** ft. and **225** ft.
Gravel pack? Yes Size range of material **#1 fine**
11. Static water level: _____ ft. below land surface Date **3/8/79**
12. Pumping level below land surfaces:
_____ ft. after _____ hrs. pumping _____ g.p.m.
_____ ft. after _____ hrs. pumping _____ g.p.m.
Estimated maximum yield _____ g.p.m.
13. Water sample submitted: _____ mo./day/yr.
Yes No _____ Date _____
14. Well head completion:
 Pitless adapter **18** inches above grade
15. Well grouted? Yes
With: Neat cement Bentonite Concrete
Depth: From **4** ft. to **14** ft.
16. Nearest source of possible contamination:
ft. **50** Direction **E** Type **fish pond**
Well disinfected upon completion? Yes _____ No _____
17. Pump:
Not installed
Manufacturer's name **Aermotor**
Model number _____ HP _____ Volts _____
Length of drop pipe **164** ft. capacity **5** g.p.m.
Type: Submersible Turbine
 Jet Reciprocating
 Centrifugal Other

18. Elevation: _____ Topography: _____ Hill _____ Slope _____ Upland _____ Valley _____
19. Remarks: *225*
20. Water well contractor's certification:
This well was drilled under my jurisdiction and this report is true to the best of my knowledge and belief.
Friesen Windmill **252**
Business name **Meade, Kansas 67864** License No. _____
Address _____
Signed *[Signature]* Date **6-15-79**
Authorized representative

126
252
SW
13
1/4
1/4
1/4
1/4
SW
1/4
1/4
1/4
1/4