

USE TYPEWRITER OR BALL POINT PEN—PRESS FIRMLY, PRINT CLEARLY.

T R EW sec 1/4 1/4 1/4 No.


WATER WELL RECORD
KSA 82a-1201-1215

Kansas State Dept. Of Health
(Water Well Contractors)
Forbes-Bldg. 740
Topeka, Kansas 66620

BCD

1 Location of well: County **FORD** Township name **DODGE** Fraction **SE 1/4 SW 1/4 NW 1/4** Section number **13** Town number **T26S** Range number **R25W**

Distance and direction from nearest town or city: **3/4 MILE NORTH** 3 Owner of well: **RICHARD HANSEN**
Street address of well location if in city: Address: **1608 AVE C
DODGE CITY KANSAS**

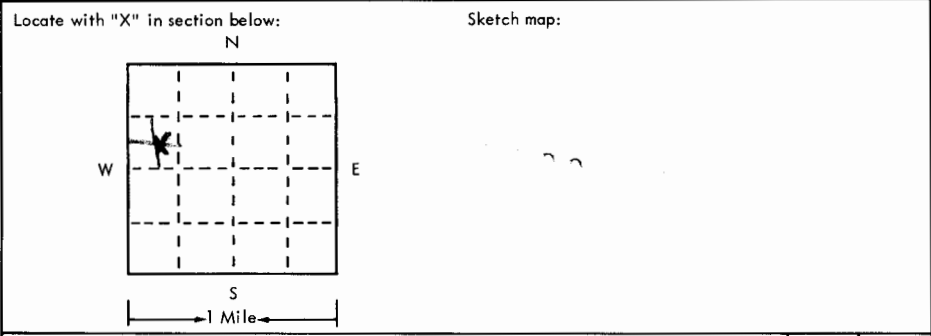

4 Well depth: **200** ft. Date of completion **19/2/75**
Well diameter **8** in.
5 Cable tool Rotary Driven Dug
 Hollow rod Jetted Bored Reverse rotary
6 Use: Domestic Public supply Industry
 Irrigation Air conditioning Commercial
 Test well
7 Casing: Material **PLASTIC** Height: **above** below
Threaded Welded Surface **24** in.
Diam. **6 1/2** in. Weight _____ lbs./ft. _____
6 in. to **200** ft. depth Drive shoe? Yes No
_____ in. to _____ ft. depth

2	Type and color of material	From	To
	SOIL	0	2
	CLAY + ROCK	2	170
	GRAVEL	170	200
	SHALE	200	—
	BRICK 200'		
	100		
	100' soft thick		
	in Og		

8 Screen: Manufacturer **Jean + Lowell**
Type **RMP** Dia. **5**
Slot/gauze **1/8** Length **30'**
Set between **170** ft. and **200** ft.
Fittings: Gravel pack Yes No Size range of material **1/8**
9 Static water level: **100** ft. below land surface Date **19/2/75**
10 Pumping level below land surfaces:
_____ ft. after _____ hrs. pumping _____ g.p.m.
_____ ft. after _____ hrs. pumping _____ g.p.m.
Estimated maximum yield _____ g.p.m.
11 Water sample submitted:
 Yes No Date _____
12 Well head completion: **24**
 Pitless adapter Inches above grade
13 Well grouted? Yes No
 Neat cement Bentonite
Depth: From **#3** ft. to **13** ft.
14 Nearest source of possible contamination: **clear pool**
ft. **1000** Direction **W** Type _____
Well disinfected upon completion? Yes No
15 Pump: Not installed
Manufacturer's name **TRW REDA**
Model number **140155** HP **1 1/2** Volts **220**
Length of drop pipe **168** ft. capacity **12** g.m.p.
Type: Submersible Turbine
 Jet Reciprocating
 Centrifugal Other

16 Remarks: elevation
Topography:
 Hill
 Slope
 Upland
 Valley
1010 2355
225
2055

17 Water well contractor's certification:
This well was drilled under my jurisdiction and this report is true to the best of my knowledge and belief.
Cragg Well Drilling **111A**
Business name License No.
Address **111 Dodge City KS**
Signed **Ray Dilling** Date **20 Feb 75**
Authorized representative