


1 LOCATION OF WATER WELL: Fraction SW 1/4 NE 1/4 NE 1/4 Section Number 13 Township Number T 26 S Range Number R 25 EW  
 County: Ford

Distance and direction from nearest town or city street address of well if located within city?  
Lot 4 - Block 1 - Klieksen Subdivision

2 WATER WELL OWNER: Daryl Roehrman  
 RR#, St. Address, Box #: Route #3 Board of Agriculture, Division of Water Resources  
 City, State, ZIP Code: Dodge City, Kansas 67801 Application Number:

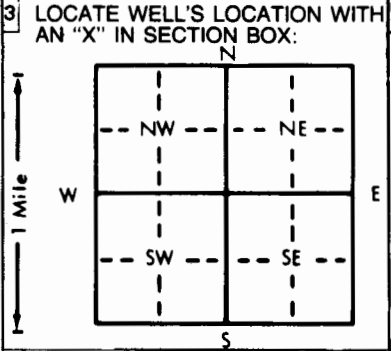

4 DEPTH OF COMPLETED WELL: 205 ft. ELEVATION: .....  
 Depth(s) Groundwater Encountered 1. .... ft. 2. .... ft. 3. .... ft.  
 WELL'S STATIC WATER LEVEL: 101, .... ft. below land surface measured on mo/day/yr 7-13-87  
 Pump test data: Well water was ..... ft. after ..... hours pumping ..... gpm  
 Est. Yield 45 gpm: Well water was ..... ft. after ..... hours pumping ..... gpm  
 Bore Hole Diameter: 8 in. to 205 ft., and ..... in. to ..... ft.  
 WELL WATER TO BE USED AS:  
 5 Public water supply 8 Air conditioning 11 Injection well  
 1 Domestic 3 Feedlot 6 Oil field water supply 9 Dewatering 12 Other (Specify below)  
 2 Irrigation 4 Industrial 7 Lawn and garden only 10 Observation well  
 Was a chemical/bacteriological sample submitted to Department? Yes.....No. XXX.....; If yes, mo/day/yr sample was submitted  
 Water Well Disinfected? Yes XXX No

5 TYPE OF BLANK CASING USED:  
 1 Steel 3 RMP (SR) 5 Wrought iron 8 Concrete tile CASING JOINTS: Glued XX Clamped .....  
 2 PVC 4 ABS 6 Asbestos-Cement 9 Other (specify below) Welded .....  
 7 Fiberglass Threaded .....  
 Blank casing diameter 5 in. to 205 ft., Dia ..... in. to ..... ft., Dia ..... in. to ..... ft.  
 Casing height above land surface: 12 in., weight 200 psi lbs./ft. Wall thickness or gauge No. SDR 21  
 TYPE OF SCREEN OR PERFORATION MATERIAL:  
 1 Steel 3 Stainless steel 5 Fiberglass 7 PVC 10 Asbestos-cement  
 2 Brass 4 Galvanized steel 6 Concrete tile 8 RMP (SR) 11 Other (specify) .....  
 9 ABS 12 None used (open hole)  
 SCREEN OR PERFORATION OPENINGS ARE:  
 1 Continuous slot 3 Mill slot 5 Gauzed wrapped 8 Saw cut 11 None (open hole)  
 2 Louvered shutter 4 Key punched 6 Wire wrapped 9 Drilled holes  
 7 Torch cut 10 Other (specify) .....  
 SCREEN-PERFORATED INTERVALS: From 180 ft. to 200 ft., From ..... ft. to ..... ft.  
 From ..... ft. to ..... ft., From ..... ft. to ..... ft.  
 GRAVEL PACK INTERVALS: From 30 ft. to 205 ft., From ..... ft. to ..... ft.  
 From ..... ft. to ..... ft., From ..... ft. to ..... ft.

6 GROUT MATERIAL: 1 Neat cement 2 Cement grout 3 Bentonite 4 Other Benseal  
 Grout intervals: From 5 ft. to 30 ft., From ..... ft. to ..... ft., From ..... ft. to ..... ft.  
 What is the nearest source of possible contamination: none - new bldg. site  
 1 Septic tank 4 Lateral lines 7 Pit privy 10 Livestock pens 14 Abandoned water well  
 2 Sewer lines 5 Cess pool 8 Sewage lagoon 11 Fuel storage 15 Oil well/Gas well  
 3 Watertight sewer lines 6 Seepage pit 9 Feedyard 12 Fertilizer storage 16 Other (specify below)  
 13 Insecticide storage none

Direction from well? How many feet?

FROM	TO	LITHOLOGIC LOG	FROM	TO	LITHOLOGIC LOG
0	15	Top soil & clay	220	235	Clay, hard yellow in color
15	30	Clay			
30	45	Clay & rock layers, fine sand			
45	60	Rock in layers and sand			
60	75	Sand rock & fine sand			
75	90	fine sand & clay in layers			
90	105	Clay			
105	120	Clay & fine sand, sand rock layers			
120	135	Fine sand, sand rock & clay			
135	150	Clay & fine sand			
150	165	Fine sand			
165	180	Fine sand & clay (6 ft.)			
180	195	Clay (6 ft.) & fine sand			
195	210	Fine sand, medium sand & coarse sand *10 ft.) (very loose)			
210	220	Coarse sand (very loose)			

7 CONTRACTOR'S OR LANDOWNER'S CERTIFICATION: This water well was (1) constructed, (2) reconstructed, or (3) plugged under my jurisdiction and was completed on (mo/day/year) 7-15-87 and this record is true to the best of my knowledge and belief. Kansas Water Well Contractor's License No. 179 This Water Well Record was completed on (mo/day/yr) 7-24-87 under the business name of Joe's Well Service, Inc. Cimarron, Ks. by (signature) David Creek

OFFICE USE ONLY  
T  
R  
EW  
SEC