


1 LOCATION OF WATER WELL: County: **Ford** Fraction: **N 2 1/4 SE 1/4 NW 1/4** Section Number: **24** Township Number: **T 26 S** Range Number: **R 25 EW**

Distance and direction from nearest town or city street address of well if located within city?
In Dodge City - Near Campus & Andrew Sts. Well #4

2 WATER WELL OWNER: **City of Dodge City**
 RR#, St. Address, Box #: **P. O. Box 880** Board of Agriculture, Division of Water Resources
 City, State, ZIP Code: **Dodge City, Kansas 67801-0880** Application Number:

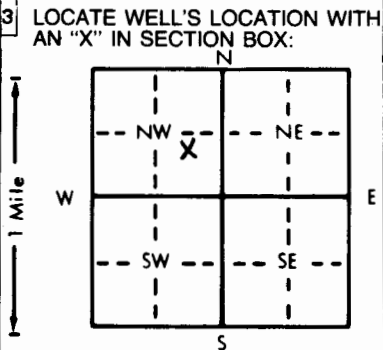

4 DEPTH OF COMPLETED WELL: **220** ft. ELEVATION:
 Depth(s) Groundwater Encountered 1. **N/A** ft. 2. ft. 3. ft.
 WELL'S STATIC WATER LEVEL: **150** ft. below land surface measured on **4-19-89**
 Pump test data: Well water was ft. after hours pumping gpm
 Est. Yield gpm: Well water was ft. after hours pumping gpm
 Bore Hole Diameter: **8-3/4** in. to **220** ft. and in. to ft.
 WELL WATER TO BE USED AS:
 1 Domestic 3 Feedlot 5 Public water supply 8 Air conditioning 11 Injection well
 2 Irrigation 4 Industrial 6 Oil field water supply 9 Dewatering 12 Other (Specify below)
 7 Lawn and garden only **10 Monitoring well**
 Was a chemical/bacteriological sample submitted to Department? Yes No **X**; If yes, mo/day/yr sample was submitted
 Water Well Disinfected? Yes No **X**

5 TYPE OF BLANK CASING USED:
 1 Steel 3 RMP (SR) 5 Wrought iron 8 Concrete tile CASING JOINTS: Glued Clamped
2 PVC 4 ABS 6 Asbestos-Cement 9 Other (specify below) Welded
 7 Fiberglass Threaded **X**
 Blank casing diameter: **4** in. to **140** ft., Dia. in. to ft., Dia. in. to ft.
 Casing height above land surface: **12** in., weight **1.53** lbs./ft. Wall thickness or gauge No. **.173**
 TYPE OF SCREEN OR PERFORATION MATERIAL:
 1 Steel 3 Stainless steel 5 Fiberglass 8 RMP (SR) 10 Asbestos-cement
 2 Brass 4 Galvanized steel 6 Concrete tile 9 ABS 11 Other (specify)
 12 None used (open hole)
 SCREEN OR PERFORATION OPENINGS ARE:
 1 Continuous slot 3 Mill slot 5 Gauzed wrapped **8 Saw cut** 11 None (open hole)
 2 Louvered shutter 4 Key punched 6 Wire wrapped 9 Drilled holes
 7 Torch cut 10 Other (specify)
 SCREEN-PERFORATED INTERVALS: From **140** ft. to **220** ft., From ft. to ft.
 GRAVEL PACK INTERVALS: From **135** ft. to **220** ft., From ft. to ft.

6 GROUT MATERIAL: 1 Neat cement 2 Cement grout **3 Bentonite** 4 Other
 Grout intervals: From **0** ft. to **135** ft., From ft. to ft., From ft. to ft.
 What is the nearest source of possible contamination:
 1 Septic tank 4 Lateral lines 7 Pit privy 10 Livestock pens 14 Abandoned water well
 2 Sewer lines 5 Cess pool 8 Sewage lagoon 11 Fuel storage 15 Oil well/Gas well
 3 Watertight sewer lines 6 Seepage pit 9 Feedyard 12 Fertilizer storage 16 Other (specify below)
 13 Insecticide storage **N/A**

Direction from well? How many feet?

FROM	TO	LITHOLOGIC LOG	FROM	TO	PLUGGING INTERVALS
		See attached log			

7 CONTRACTOR'S OR LANDOWNER'S CERTIFICATION: This water well was **(1)** constructed, (2) reconstructed, or (3) plugged under my jurisdiction and was completed on (mo/day/year) **4-26-89** and this record is true to the best of my knowledge and belief. Kansas Water Well Contractor's License No. **208** This Water Well Record was completed on (mo/day/yr) **6-12-89** under the business name of **Minter-Wilson Drilling Co., Inc.** by (signature) *Nora Keller*

INSTRUCTIONS: Use typewriter or ball point pen. PLEASE PRESS FIRMLY and PRINT clearly. Please fill in blanks, underline or circle the correct answers. Send top three copies to Kansas Department of Health and Environment, Bureau of Water Protection, Topeka, Kansas 66620-7320. Telephone: 913-296-5514. Send one to WATER WELL OWNER and retain one for your records.

OFFICE USE ONLY T R EW SEC. 1/4 1/4 1/4

The Professionals

MINTER-WILSON DRILLING CO.

INCORPORATED

Irrigation
and Domestic
Water Systems
Complete Installation
and Repairing

Phone 276-8269 • P.O. Box A • GARDEN CITY, KANSAS 67846

City of Dodge City
Ford County
4-19-89

Location: Near Campus & Andrew Streets

Static Water Level - 150'

Well #4

0	2	Top soil
2	68	Brown clay
68	83	Brown clay white rock mixed - hard
83	97	Cemented sand stone - hard
97	104	Fine to medium sand & gravel - small hard spot
104	112	Brown sandy clay
112	123	Brown sandy clay - 15% gravel - tight
123	143	Brown sandy clay
143	147	Brown sandy clay - small gravel streak
147	179	Brown sandy clay white rock mixed
179	184	Brown sandy clay - small sand streak
184	193	Brown sandy clay - tight
193	220	Fine to medium sand & gravel - loose
220	222	Brown yellow clay

220' - 8-3/4" Hole
4" PVC Casing - 140' Plain
- 80' Perf.