


1 LOCATION OF WATER WELL: County: **Ford** Fraction: **N2 1/4 SE 1/4 NW 1/4** Section Number: **24** Township Number: **T 26 S** Range Number: **R 25 E** **(NW)**

Distance and direction from nearest town or city street address of well if located within city?
In Dodge City - Near Campus & McCoy Sts. Well #3

2 WATER WELL OWNER: **City of Dodge City**
 RR#, St. Address, Box #: **P. O. Box 880**
 City, State, ZIP Code: **Dodge City, Kansas 67801-0880**
 Board of Agriculture, Division of Water Resources
 Application Number:

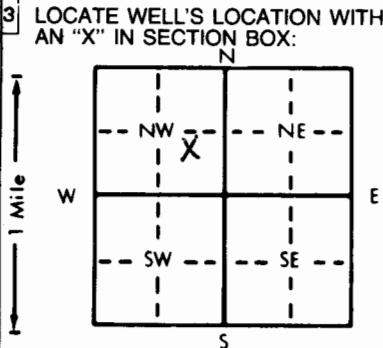

4 DEPTH OF COMPLETED WELL: **230** ft. ELEVATION:
 Depth(s) Groundwater Encountered 1. **NA** ft. 2. ft. 3. ft.
 WELL'S STATIC WATER LEVEL: **139** ft. below land surface measured on mo/day/yr **4-17-89**
 Pump test data: Well water was ft. after hours pumping gpm
 Est. Yield gpm: Well water was ft. after hours pumping gpm
 Bore Hole Diameter: **8-3/4** in. to **230** ft., and in. to ft.
 WELL WATER TO BE USED AS:
 5 Public water supply 8 Air conditioning 11 Injection well
 1 Domestic 3 Feedlot 6 Oil field water supply 9 Dewatering 12 Other (Specify below)
 2 Irrigation 4 Industrial 7 Lawn and garden only **10** Monitoring well
 Was a chemical/bacteriological sample submitted to Department? Yes No **X**; If yes, mo/day/yr sample was submitted
 Water Well Disinfected? Yes No **X**

5 TYPE OF BLANK CASING USED:
 1 Steel 3 RMP (SR) 5 Wrought iron 8 Concrete tile CASING JOINTS: Glued Clamped
2 PVC 4 ABS 6 Asbestos-Cement 9 Other (specify below) Welded
 7 Fiberglass Threaded **X**
 Blank casing diameter **4** in. to **120** ft., Dia in. to ft., Dia in. to ft.
 Casing height above land surface **12** in., weight **1.53** lbs./ft. Wall thickness or gauge No. **173**
 TYPE OF SCREEN OR PERFORATION MATERIAL:
 1 Steel 3 Stainless steel 5 Fiberglass **7** PVC 10 Asbestos-cement
 2 Brass 4 Galvanized steel 6 Concrete tile 8 RMP (SR) 11 Other (specify)
 12 None used (open hole)
 SCREEN OR PERFORATION OPENINGS ARE:
 1 Continuous slot 3 Mill slot 5 Gauzed wrapped **8** Saw cut 11 None (open hole)
 2 Louvered shutter 4 Key punched 6 Wire wrapped 9 Drilled holes
 7 Torch cut 10 Other (specify)
 SCREEN-PERFORATED INTERVALS: From **120** ft. to **230** ft., From ft. to ft.
 From ft. to ft., From ft. to ft.
 GRAVEL PACK INTERVALS: From **115** ft. to **230** ft., From ft. to ft.
 From ft. to ft., From ft. to ft.

6 GROUT MATERIAL: 1 Neat cement 2 Cement grout **3** Bentonite 4 Other
 Grout Intervals: From **0** ft. to **115** ft., From ft. to ft., From ft. to ft.
 What is the nearest source of possible contamination:
 1 Septic tank 4 Lateral lines 7 Pit privy 10 Livestock pens 14 Abandoned water well
 2 Sewer lines 5 Cess pool 8 Sewage lagoon 11 Fuel storage 15 Oil well/Gas well
 3 Watertight sewer lines 6 Seepage pit 9 Feedyard 12 Fertilizer storage 16 Other (specify below)
 13 Insecticide storage **N/A**
 Direction from well? How many feet?

FROM	TO	LITHOLOGIC LOG	FROM	TO	PLUGGING INTERVALS
		See attached log			

7 CONTRACTOR'S OR LANDOWNER'S CERTIFICATION: This water well was **(1)** constructed, (2) reconstructed, or (3) plugged under my jurisdiction and was completed on (mo/day/year) **4-26-89** and this record is true to the best of my knowledge and belief. Kansas Water Well Contractor's License No. **208** This Water Well Record was completed on (mo/day/yr) **6-12-89** under the business name of **Minter-Wilson Drilling Co., Inc.** by (signature) *Nora Keelu*

INSTRUCTIONS: Use typewriter or ball point pen. PLEASE PRESS FIRMLY and PRINT clearly. Please fill in blanks, underline or circle the correct answers. Send top three copies to Kansas Department of Health and Environment, Bureau of Water Protection, Topeka, Kansas 66620-7320. Telephone: 913-296-5514. Send one to WATER WELL OWNER and retain one for your records.

The Professionals

MINTER-WILSON DRILLING CO.

INCORPORATED

Irrigation
and Domestic
Water Systems
Complete Installation
and Repairing

Phone 276-8269 • P.O. Box A • GARDEN CITY, KANSAS 67846

City of Dodge City
Ford County
4-17-89

Location: Near Campus & McCoy Streets

Static Water Level - 139'

Well #3

0	2	Top soil
2	65	Brown clay
65	81	Brown clay - white rock mixed
81	105	Cemented sand stone - gravel mixed
		Hard pull down
105	117	Fine to medium sand gravel - loose
117	134	Brown sandy clay
134	145	Brown sandy clay - gravel streak mixed
145	162	Brown sandy clay - white rock mixed
162	167	Brown sandy clay - small gravel streak
167	188	Brown sandy clay
188	199	Brown sandy clay - medium sand streak mixed
199	229	Fine to medium sand & gravel - Small clay streak mixed - loose
229	230	Brown yellow clay

230' - 8-3/4" Hole
4" PVC - 120' Plain
- 110' Perf.