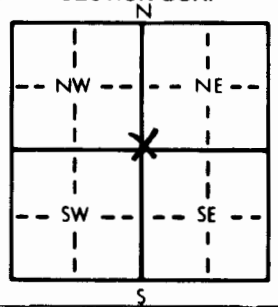


1 LOCATION OF WATER WELL: County: **Ford** Fraction: **NE** 1/4 1/4 1/4 Section Number: **24** Township Number: **T 26 S** Range Number: **R 25 EW**

Distance and direction from nearest town or city street address of well if located within city?
In Dodge City - University & Crescent Well #1

2 WATER WELL OWNER: **City of Dodge City**
 RR#, St. Address, Box #: **P. O. Box 880**
 City, State, ZIP Code: **Dodge City, Kansas 67801-0880**
 Board of Agriculture, Division of Water Resources
 Application Number:

3 LOCATE WELL'S LOCATION WITH AN "X" IN SECTION BOX:

 4 DEPTH OF COMPLETED WELL: **230** ft. ELEVATION:
 Depth(s) Groundwater Encountered 1. **NA** ft. 2. ft. 3. ft.
 WELL'S STATIC WATER LEVEL: **136** ft. below land surface measured on mo/day/yr **4-21-89**
 Pump test data: Well water was ft. after hours pumping gpm
 Est. Yield gpm: Well water was ft. after hours pumping gpm
 Bore Hole Diameter: **8-3/4** in. to **230** ft., and in. to ft.
 WELL WATER TO BE USED AS:
 1 Domestic 3 Feedlot 6 Oil field water supply 9 Dewatering 12 Other (Specify below)
 2 Irrigation 4 Industrial 7 Lawn and garden only **10** Monitoring well
 Was a chemical/bacteriological sample submitted to Department? Yes.....No.....**X**.....; If yes, mo/day/yr sample was submitted
 Water Well Disinfected? Yes No **X**

5 TYPE OF CASING USED:
 1 Steel 3 RMP (SR) 5 Wrought iron 8 Concrete tile CASING JOINTS: Glued Clamped
2 PVC 4 ABS 6 Asbestos-Cement 9 Other (specify below) Welded
 7 Fiberglass Threaded **X**
 Casing diameter: **4** in. to **130** ft., Dia in. to ft., Dia in. to ft.
 Casing height above land surface: **12** in., weight **1.53** lbs./ft. Wall thickness or gauge No. **173**
 TYPE OF SCREEN OR PERFORATION MATERIAL:
 1 Steel 3 Stainless steel 5 Fiberglass **7** PVC 10 Asbestos-cement
 2 Brass 4 Galvanized steel 6 Concrete tile 9 ABS 11 Other (specify)
 12 None used (open hole)
 SCREEN OR PERFORATION OPENINGS ARE:
 1 Continuous slot 3 Mill slot 5 Gauzed wrapped **8** Saw cut 11 None (open hole)
 2 Louvered shutter 4 Key punched 6 Wire wrapped 9 Drilled holes
 7 Torch cut 10 Other (specify)
 SCREEN-PERFORATED INTERVALS: From **130** ft. to **230** ft., From ft. to ft.
 From ft. to ft., From ft. to ft.
 GRAVEL PACK INTERVALS: From **125** ft. to **230** ft., From ft. to ft.
 From ft. to ft., From ft. to ft.

6 GROUT MATERIAL: 1 Neat cement 2 Cement grout **3** Bentonite 4 Other
 Grout Intervals: From **0** ft. to **125** ft., From ft. to ft., From ft. to ft.
 What is the nearest source of possible contamination:
 1 Septic tank 4 Lateral lines 7 Pit privy 10 Livestock pens 14 Abandoned water well
 2 Sewer lines 5 Cess pool 8 Sewage lagoon 11 Fuel storage 15 Oil well/Gas well
 3 Watertight sewer lines 6 Seepage pit 9 Feedyard 12 Fertilizer storage 16 Other (specify below)
 13 Insecticide storage **N/A**

Direction from well? How many feet?

FROM	TO	LITHOLOGIC LOG	FROM	TO	PLUGGING INTERVALS
		See attached log			

7 CONTRACTOR'S OR LANDOWNER'S CERTIFICATION: This water well was **1** constructed, (2) reconstructed, or (3) plugged under my jurisdiction and was completed on (mo/day/year) **4-26-89** and this record is true to the best of my knowledge and belief. Kansas Water Well Contractor's License No. **208** This Water Well Record was completed on (mo/day/yr) **6-12-89** under the business name of **Minter-Wilson Drilling Co., Inc.** by (signature) **Nora Keller**

OFFICE USE ONLY

The Professionals

MINTER-WILSON DRILLING CO.
INCORPORATED

Irrigation
and Domestic
Water Systems
Complete Installation
and Repairing

Phone 276-8269 • P.O. Box A • GARDEN CITY, KANSAS 67846

City of Dodge City
Ford County
4-21-89

Location: University & Crescent Drive

Static Water Level - 136'6"

Well #1

0	2	Top soil
2	6	Brown clay
6	37	Brown clay - hard pull down
37	63	Brown sandy clay
63	87	Brown clay white rock mixed
87	106	Fine to medium sand & gravel
106	182	Brown sandy clay
182	200	Brown sandy clay - small sand streak
200	228	Fine to medium sand & gravel - loose
228	230	Brown & yellow clay

230' - 8-3/4" Hole
4" PVC Casing - 130' Plain
- 100' Perf.