


1 LOCATION OF WATER WELL: County: **Ford** Fraction: **NE 1/4 SW 1/4 SE 1/4** Section Number: **25** Township Number: **T 26 S** Range Number: **R 25 EW**

Distance and direction from nearest town or city street address of well if located within city?
512 Ave L, Dodge City

2 WATER WELL OWNER: RR#, St. Address, Box #: **Ford County, 100 Gunsmoke, Dodge City, KS 67801** Board of Agriculture, Division of Water Resources Application Number:

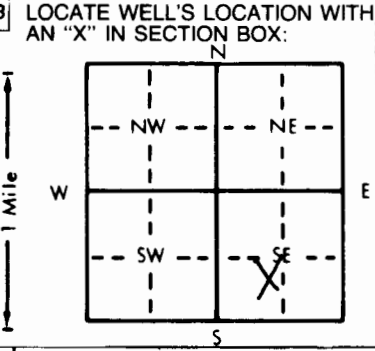

4 DEPTH OF COMPLETED WELL: **88** ft. ELEVATION: **75** ft. 3. **73.82** ft. below land surface measured on mo/day/yr **2/3/93**

Depth(s) Groundwater Encountered 1. **75** ft. 2. ft. 3. ft.

WELL'S STATIC WATER LEVEL **73.82** ft. below land surface measured on mo/day/yr **2/3/93**

Pump test data: Well water was ft. after hours pumping gpm

Est. Yield gpm: Well water was ft. after hours pumping gpm

Bore Hole Diameter: **8** in. to ft., and in. to ft.

WELL WATER TO BE USED AS: 5 Public water supply 8 Air conditioning 11 Injection well
 1 Domestic 3 Feedlot 6 Oil field water supply 9 Dewatering 12 Other (Specify below)
 2 Irrigation 4 Industrial 7 Lawn and garden only **10 Monitoring well**

Was a chemical/bacteriological sample submitted to Department? Yes No **X** If yes, mo/day/yr sample was submitted

Water Well Disinfected? Yes No **X**

5 TYPE OF BLANK CASING USED: 1 Steel 3 RMP (SR) 5 Wrought iron 8 Concrete tile CASING JOINTS: Glued Clamped
2 PVC 4 ABS 6 Asbestos-Cement 9 Other (specify below) Welded
 Blank casing diameter **2** in. to ft., Dia in. to ft., Dia in. to ft. **Threaded Flush**
 Casing height above land surface **Flush** in., weight **703** lbs./ft. Wall thickness or gauge No. **154**

TYPE OF SCREEN OR PERFORATION MATERIAL: 1 Steel 3 Stainless steel 5 Fiberglass 8 RMP (SR) 10 Asbestos-cement
 2 Brass 4 Galvanized steel 6 Concrete tile 9 ABS 11 Other (specify) 12 None used (open hole)

SCREEN OR PERFORATION OPENINGS ARE: 1 Continuous slot 3 Mill slot 5 Gauzed wrapped 8 Saw cut 11 None (open hole)
 2 Louvered shutter 4 Key punched 6 Wire wrapped 9 Drilled holes
 7 Torch cut 10 Other (specify)

SCREEN-PERFORATED INTERVALS: From **63.0** ft. to **88.0** ft. From ft. to ft. From ft. to ft. From ft. to ft.

GRAVEL PACK INTERVALS: From **62.0** ft. to **88.0** ft. From ft. to ft. From ft. to ft. From ft. to ft.

6 GROUT MATERIAL: 1 Neat cement 2 Cement grout **3 Bentonite** 4 Other

Grout Intervals: From **62.0** ft. to **1.0** ft., From ft. to ft., From ft. to ft., From ft. to ft.

What is the nearest source of possible contamination: 1 Septic tank 4 Lateral lines 7 Pit privy **11 Fuel storage** 14 Abandoned water well
 2 Sewer lines 5 Cess pool 8 Sewage lagoon 12 Fertilizer storage 15 Oil well/Gas well
 3 Watertight sewer lines 6 Seepage pit 9 Feedyard 13 Insecticide storage 16 Other (specify below)

Direction from well? How many feet?

| FROM | TO | LITHOLOGIC LOG | FROM | TO | PLUGGING INTERVALS |
|------|------|---------------------------|------|----|--------------------|
| 0.0 | 2.5 | Silt | | | |
| 2.5 | 4.5 | Sand | | | |
| 4.5 | 6.0 | Sandstone, Caliche matrix | | | |
| 6.0 | 7.0 | Sand | | | |
| 7.0 | 8.0 | Sandstone, Caliche matrix | | | |
| 8.0 | 32.0 | Sand | | | |
| 32.0 | 70.0 | Silt, sandy | | | |
| 70.0 | 75.0 | Silt | | | |
| 75.0 | 88.0 | Sandy silt | | | |

Flush mound waiver granted on 12-17-93 for Ford County Shop; KDHE 01029637B by Don Taylor

7 CONTRACTOR'S OR LANDOWNER'S CERTIFICATION: This water well was **(1) constructed**, (2) reconstructed, or (3) plugged under my jurisdiction and was completed on (mo/day/year) **2/3/93** and this record is true to the best of my knowledge and belief. Kansas Water Well Contractor's License No. **531** This Water Well Record was completed on (mo/day/yr) **2/4/93** under the business name of **GSI** by (signature) **Allison Brown**

INSTRUCTIONS: Use typewriter or ball point pen. PLEASE PRESS FIRMLY and PRINT clearly. Please fill in blanks, underline or circle the correct answers. Send top three copies to Kansas Department of Health and Environment, Bureau of Water, Topeka, Kansas 66620-0001. Telephone: 913-296-5545. Send one to WATER WELL OWNER and retain one for your records.