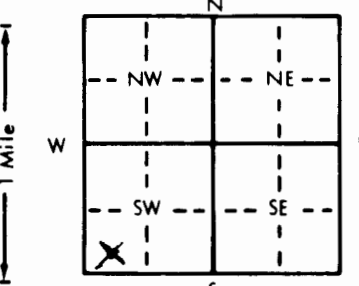


1 LOCATION OF WATER WELL: County: **Ford** Fraction: **SW 1/4 SW 1/4 SW 1/4** Section Number: **25** Township Number: **T 26 S** Range Number: **R 25 EW**

Distance and direction from nearest town or city street address of well if located within city?  
**100 Military - Dodge City, Kansas**

2 WATER WELL OWNER: **Frank Epp**  
 RR#, St. Address, Box #: **100 Military Plaza**  
 City, State, ZIP Code: **Dodge City, Kansas 67801**  
 Board of Agriculture, Division of Water Resources  
 Application Number:

3 LOCATE WELL'S LOCATION WITH AN "X" IN SECTION BOX:  


4 DEPTH OF COMPLETED WELL: **77.5** ft. ELEVATION: **200.51**  
 Depth(s) Groundwater Encountered 1. **145.64** ft. 2. ft. 3. ft.  
 WELL'S STATIC WATER LEVEL **54.87** ft. below land surface measured on mo/day/yr **12/3/92**  
 Pump test data: Well water was ft. after hours pumping gpm  
 Est. Yield gpm: Well water was ft. after hours pumping gpm  
 Bore Hole Diameter **6 5/8** in. to **77.5** ft., and in. to ft.  
 WELL WATER TO BE USED AS:  
 5 Public water supply 8 Air conditioning 11 Injection well  
 1 Domestic 3 Feedlot 6 Oil field water supply 9 Dewatering 12 Other (Specify below)  
 2 Irrigation 4 Industrial 7 Lawn and garden only **10 Monitoring well MW-2**  
 Was a chemical/bacteriological sample submitted to Department? Yes No  X; If yes, mo/day/yr sample was submitted  
 Water Well Disinfected? Yes  No  X

5 TYPE OF BLANK CASING USED:  
 1 Steel 3 RMP (SR) 5 Wrought iron 8 Concrete tile CASING JOINTS: Glued Clamped  
**2 PVC** 4 ABS 6 Asbestos-Cement 9 Other (specify below) Welded  
 7 Fiberglass Threaded  X  
 Blank casing diameter **2** in. to **77.5** ft., Dia. in. to ft., Dia. in. to ft.  
 Casing height above land surface **0** in., weight lbs./ft. Wall thickness or gauge No. **Sch. 40**  
 TYPE OF SCREEN OR PERFORATION MATERIAL:  
 1 Steel 3 Stainless steel 5 Fiberglass **7 PVC** 10 Asbestos-cement  
 2 Brass 4 Galvanized steel 6 Concrete tile 8 RMP (SR) 11 Other (specify)  
 9 ABS 12 None used (open hole)  
 SCREEN OR PERFORATION OPENINGS ARE:  
 1 Continuous slot **3 Mill slot** 5 Gauzed wrapped 8 Saw cut 11 None (open hole)  
 2 Louvered shutter 4 Key punched 6 Wire wrapped 9 Drilled holes  
 7 Torch cut 10 Other (specify)  
 SCREEN-PERFORATED INTERVALS: From **77.5** ft. to **57.5** ft., From ft. to ft.  
 From ft. to ft., From ft. to ft.  
 GRAVEL PACK INTERVALS: From **78.0** ft. to **55.5** ft., From ft. to ft.  
 From ft. to ft., From ft. to ft.

6 GROUT MATERIAL: **1 Neat cement** **2 Cement grout** 3 Bentonite 4 Other  
 Grout Intervals: From **55.5** ft. to **51.5** ft., From **51.5** ft. to **0.0** ft., From ft. to ft.  
 What is the nearest source of possible contamination:  
 1 Septic tank 4 Lateral lines 7 Pit privy 10 Livestock pens 14 Abandoned water well  
 2 Sewer lines 5 Cess pool 8 Sewage lagoon 11 Fuel storage 15 Oil well/Gas well  
 3 Watertight sewer lines 6 Seepage pit 9 Feedyard 12 Fertilizer storage 16 Other (specify below)  
 13 Insecticide storage  
 Direction from well? How many feet?

FROM	TO	LITHOLOGIC LOG	FROM	TO	PLUGGING INTERVALS
0	15	Silty, Tan, Dry			
15	20	Caliche, Hard, White			
20	25	Clay, Brown, Trace Sand, Fine			
25	35	Sand, Tan, Fine W/ Med. Grained			
35	45	Sand. Med to Fine Grained, Trace Clay			
45	50	Clay, Sand, Mix, Caliche			
50	78	Clay, Dk. Brown, Trace Sand			

7 CONTRACTOR'S OR LANDOWNER'S CERTIFICATION: This water well was **(1) constructed**, (2) reconstructed, or (3) plugged under my jurisdiction and was completed on (mo/day/year) **11/22/92** and this record is true to the best of my knowledge and belief. Kansas Water Well Contractor's License No. **540** This Water Well Record was completed on (mo/day/yr) **12/9/92**  
 under the business name of **Prairie Land Environmental Remediation, Inc.** (signature)