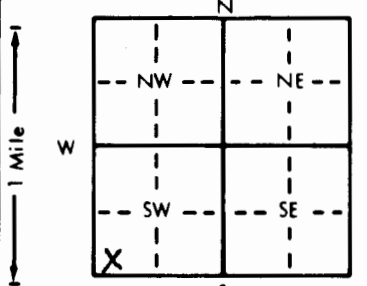


1 LOCATION OF WATER WELL: County: **Ford** Fraction: **SW 1/4 SW 1/4 SW 1/4** Section Number: **25** Township Number: **T 26 S** Range Number: **R 25** **EW**

Distance and direction from nearest town or city street address of well if located within city?
100 Military Plaza

2 WATER WELL OWNER: **Frank Epp**
 RR#, St. Address, Box #: **100 Military Plaza** Board of Agriculture, Division of Water Resources
 City, State, ZIP Code: **Dodge City, Kansas 67801** Application Number:

3 LOCATE WELL'S LOCATION WITH AN "X" IN SECTION BOX:

 4 DEPTH OF COMPLETED WELL: **73.0** ft. ELEVATION: **202.76**
 Depth(s) Groundwater Encountered: **1, 144.81** ft. 2. ft. 3. ft.
 WELL'S STATIC WATER LEVEL: **57.95** ft. below land surface measured on mo/day/yr **12/3/92**
 Pump test data: Well water was ft. after hours pumping gpm
 Est. Yield gpm: Well water was ft. after hours pumping gpm
 Bore Hole Diameter: **6.5/8** in. to **72.5** ft., and in. to ft.
 WELL WATER TO BE USED AS:
 5 Public water supply 8 Air conditioning 11 Injection well
 1 Domestic 3 Feedlot 6 Oil field water supply 9 Dewatering 12 Other (Specify below)
 2 Irrigation 4 Industrial 7 Lawn and garden only **10 Monitoring well MW-4**
 Was a chemical/bacteriological sample submitted to Department? Yes No **X** If yes, mo/day/yr sample was submitted
 Water Well Disinfected? Yes No **X**

5 TYPE OF BLANK CASING USED:
 1 Steel 3 RMP (SR) 5 Wrought iron 8 Concrete tile CASING JOINTS: Glued Clamped
2 PVC 4 ABS 6 Asbestos-Cement 9 Other (specify below) Welded
 7 Fiberglass Threaded **X**
 Blank casing diameter **2** in. to **72.5** ft., Dia in. to ft., Dia in. to ft.
 Casing height above land surface: **0** in., weight lbs./ft. Wall thickness or gauge No. **Schd 40**

TYPE OF SCREEN OR PERFORATION MATERIAL:
 1 Steel 3 Stainless steel 5 Fiberglass **7 PVC** 10 Asbestos-cement
 2 Brass 4 Galvanized steel 6 Concrete tile 8 RMP (SR) 11 Other (specify)
 12 None used (open hole)

SCREEN OR PERFORATION OPENINGS ARE:
 1 Continuous slot 3 Mill slot 5 Gauzed wrapped 8 Saw cut 11 None (open hole)
 2 Louvered shutter 4 Key punched 6 Wire wrapped 9 Drilled holes
 7 Torch cut 10 Other (specify)

SCREEN-PERFORATED INTERVALS: From **72.5** ft. to **52.5** ft., From ft. to ft.
 From ft. to ft., From ft. to ft.
 GRAVEL PACK INTERVALS: From **72.5** ft. to **50.5** ft., From ft. to ft.
 From ft. to ft., From ft. to ft.

6 GROUT MATERIAL: 1 Neat cement 2 Cement grout 3 Bentonite 4 Other
 Grout Intervals: From **50.5** ft. to **46.5** ft., From **46.5** ft. to **0.0** ft., From ft. to ft.

What is the nearest source of possible contamination:
 1 Septic tank 4 Lateral lines 7 Pit privy 10 Livestock pens 14 Abandoned water well
 2 Sewer lines 5 Cess pool 8 Sewage lagoon 11 Fuel storage 15 Oil well/Gas well
 3 Watertight sewer lines 6 Seepage pit 9 Feedyard 12 Fertilizer storage 16 Other (specify below)
 13 Insecticide storage
 Direction from well? How many feet?

| FROM | TO | LITHOLOGIC LOG | FROM | TO | PLUGGING INTERVALS |
|------|----|---------------------------------------|------|----|--------------------|
| 0 | 20 | Clay, Light to Dark Brown | | | |
| 20 | 25 | Clay, Light to Med. Brown, Med. Sand | | | |
| 25 | 30 | 1/4 to 1" Med. to Coarse Rock | | | |
| 30 | 35 | Sand, Fine to Med. Grained | | | |
| 35 | 45 | Sand, Fine to Med., 1/4" to 1/2" Rock | | | |
| 45 | 73 | Clay, Sand, Mix. (50-50) | | | |

7 CONTRACTOR'S OR LANDOWNER'S CERTIFICATION: This water well was **(1) constructed**, **(2) reconstructed**, or **(3) plugged** under my jurisdiction and was completed on (mo/day/year) **11/23/92** and this record is true to the best of my knowledge and belief. Kansas Water Well Contractor's License No. **540** This Water Well Record was completed on (mo/day/yr) **12/9/92** under the business name of **Prairie Land Environmental Remediation, Inc** (signature) *[Signature]*