


1 LOCATION OF WATER WELL: County: **Ford** Fraction: **NE 1/4 SW 1/4 SW 1/4** Section Number: **25** Township Number: **T 26 S** Range Number: **R 25 E/W**

Distance and direction from nearest town or city street address of well if located within city?

400 East Wyatt Earp

2 WATER WELL OWNER: **Love's Country Store #62** Board of Agriculture, Division of Water Resources
 RR#, St. Address, Box #: **400 E. Wyatt Earp**
 City, State, ZIP Code: **Dodge City, Ks. 67801** Application Number:

3 LOCATE WELL'S LOCATION WITH AN "X" IN SECTION BOX:

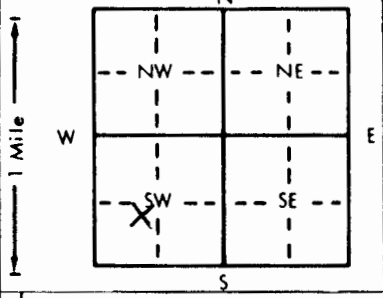

4 DEPTH OF COMPLETED WELL: **54** ft. ELEVATION: **NA**
 Depth(s) Groundwater Encountered: 1. **45** ft. 2. ... ft. 3. **12-01-93** ft.
 WELL'S STATIC WATER LEVEL: **44.10** ft. below land surface measured on mo/day/yr

Pump test data: Well water was ... ft. after ... hours pumping ... gpm
 Est. Yield ... gpm: Well water was ... ft. after ... hours pumping ... gpm
 Bore Hole Diameter: **7.5/8** in. to **54** ft., and ... in. to ... ft.

WELL WATER TO BE USED AS:
 1 Domestic 3 Feedlot 6 Oil field water supply 9 Dewatering 12 Other (Specify below)
 2 Irrigation 4 Industrial 7 Lawn and garden only **10 Monitoring well**
 Was a chemical/bacteriological sample submitted to Department? Yes ... No ; If yes, mo/day/yr sample was submitted

5 TYPE OF BLANK CASING USED:
 1 Steel 3 RMP (SR) 6 Asbestos-Cement 9 Other (specify below) Welded
2 PVC 4 ABS 7 Fiberglass Threaded
 Blank casing diameter: **2** in. to **39** ft., Dia. ... in. to ... ft., Dia. ... in. to **sch. 40** ft.
 Casing height above land surface: **0** in., weight ... lbs./ft. Wall thickness or gauge No. ...

TYPE OF SCREEN OR PERFORATION MATERIAL:
 1 Steel 3 Stainless steel 5 Fiberglass **7** PVC 10 Asbestos-cement
 2 Brass 4 Galvanized steel 6 Concrete tile 8 RMP (SR) 11 Other (specify)
 12 None used (open hole)

SCREEN OR PERFORATION OPENINGS ARE:
 1 Continuous slot **3** Mill slot **.010** 5 Gauzed wrapped 8 Saw cut 11 None (open hole)
 2 Louvered shutter 4 Key punched 6 Wire wrapped 9 Drilled holes
 7 Torch cut 10 Other (specify)

SCREEN-PERFORATED INTERVALS: From **39** ft. to **54** ft., From ... ft. to ... ft.
 GRAVEL PACK INTERVALS: From **37** ft. to **54** ft., From ... ft. to ... ft.

6 GROUT MATERIAL: 1 Neat cement **2** Cement grout **3** Bentonite 4 Other
 Grout Intervals: From **0** ft. to **33** ft., From **33** ft. to **37** ft., From ... ft. to ... ft.
 What is the nearest source of possible contamination:
 1 Septic tank 4 Lateral lines 7 Pit privy **11** Fuel storage 14 Abandoned water well
 2 Sewer lines 5 Cess pool 8 Sewage lagoon 12 Fertilizer storage 15 Oil well/Gas well
 3 Watertight sewer lines 6 Seepage pit 9 Feedyard 13 Insecticide storage 16 Other (specify below)
 Direction from well? **southeast** How many feet? **125**

FROM	TO	LITHOLOGIC LOG	FROM	TO	PLUGGING INTERVALS
0	1'	cly, dk brn, slty, org rich, damp			
1'	8'	cly, mod brn, mod slty, damp			
8	33	cly, mod brn, sl slty, tr calich, damp			
33	40	snd, lt gry/brn, f-c, w tr grvl, prly srt'd			
40	54	snd grading into lt brn f-c snd & f-c grvl			

Site ID 00009546
 MW12-flush mount cover

7 CONTRACTOR'S OR LANDOWNER'S CERTIFICATION: This water well was **1** constructed, (2) reconstructed, or (3) plugged under my jurisdiction and was completed on (mo/day/year) **10-26-93** and this record is true to the best of my knowledge and belief. Kansas Water Well Contractor's License No. **527** This Water Well Record was completed on (mo/day/yr) **01-29-94** under the business name of **GeoCore Services, Inc.** by (signature) *Dale Kohl*