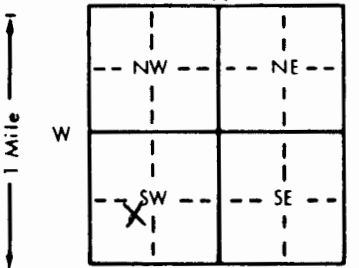


1 LOCATION OF WATER WELL: County: **Ford** Fraction: **NE 1/4 SW 1/4 SW 1/4** Section Number: **25** Township Number: **T 26 S** Range Number: **R 25 E (W)**

Distance and direction from nearest town or city street address of well if located within city?  
**400 East Wyatt Earp**

2 WATER WELL OWNER: **Love's Country Store #62**  
 RR#, St. Address, Box #: **400 E. Wyatt Earp** Board of Agriculture, Division of Water Resources  
 City, State, ZIP Code: **Dodge City, Ks. 67801** Application Number:

3 LOCATE WELL'S LOCATION WITH AN "X" IN SECTION BOX:  

 4 DEPTH OF COMPLETED WELL: **50** ft. ELEVATION: **NA**  
 Depth(s) Groundwater Encountered 1. **40** ft. 2. ft. 3. ft.  
 WELL'S STATIC WATER LEVEL: **38.38** ft. below land surface measured on **mo/day/yr 12-01-93**  
 Pump test data: Well water was ft. after hours pumping gpm  
 Est. Yield gpm: Well water was ft. after hours pumping gpm  
 Bore Hole Diameter: **7 5/8** in. to **50** ft., and in. to ft.  
 WELL WATER TO BE USED AS:  
 5 Public water supply 8 Air conditioning 11 Injection well  
 1 Domestic 3 Feedlot 6 Oil field water supply 9 Dewatering 12 Other (Specify below)  
 2 Irrigation 4 Industrial 7 Lawn and garden only **10** Monitoring well  
 Was a chemical/bacteriological sample submitted to Department? Yes **No** X; If yes, mo/day/yr sample was submitted  
 Water Well Disinfected? Yes No **X**

5 TYPE OF BLANK CASING USED:  
 1 Steel 3 RMP (SR) 5 Wrought iron 8 Concrete tile CASING JOINTS: Glued Clamped  
**2** PVC 4 ABS 6 Asbestos-Cement 9 Other (specify below) Welded  
 7 Fiberglass Threaded **X**  
 Blank casing diameter: **2** in. to **35** ft., Dia. in. to ft., Dia. in. to ft.  
 Casing height above land surface: **0** in., weight lbs./ft. Wall thickness or gauge No. **sch. 40**  
 TYPE OF SCREEN OR PERFORATION MATERIAL:  
 1 Steel 3 Stainless steel 5 Fiberglass 8 RMP (SR) 10 Asbestos-cement  
 2 Brass 4 Galvanized steel 6 Concrete tile 9 ABS 11 Other (specify)  
 12 None used (open hole)  
 SCREEN OR PERFORATION OPENINGS ARE:  
 1 Continuous slot **3** Mill slot 5 Gauzed wrapped 8 Saw cut 11 None (open hole)  
 2 Louvered shutter 4 Key punched 6 Wire wrapped 9 Drilled holes  
 7 Torch cut 10 Other (specify)  
 SCREEN-PERFORATED INTERVALS: From **35** ft. to **50** ft., From ft. to ft.  
 From ft. to ft., From ft. to ft.  
 GRAVEL PACK INTERVALS: From **33** ft. to **50** ft., From ft. to ft.  
 From ft. to ft., From ft. to ft.

6 GROUT MATERIAL: 1 Neat cement **2** Cement grout **3** Bentonite 4 Other  
 Grout Intervals: From **0** ft. to **29** ft., From **29** ft. to **33** ft., From ft. to ft.  
 What is the nearest source of possible contamination:  
 1 Septic tank 4 Lateral lines 7 Pit privy **11** Fuel storage 14 Abandoned water well  
 2 Sewer lines 5 Cess pool 8 Sewage lagoon 12 Fertilizer storage 15 Oil well/Gas well  
 3 Watertight sewer lines 6 Seepage pit 9 Feedyard 13 Insecticide storage 16 Other (specify below)  
 Direction from well? **northwest** How many feet? **310**

FROM	TO	LITHOLOGIC LOG	FROM	TO	PLUGGING INTERVALS
0	1'	road sand & gravel			
1'	10'	clay, mod brn, mod silty, tr calic gravel, damp			
10	15	clay, mod brn, v silty, moist			
15	22	clay, mod brn, mod silty, moist			
22	27	clay, dk brn, sl silty-grding to v silty, moist			
27	30.2	clay, grn/gry, v silty, mod sandy			
30.2	35	sand, lt gry-lt brn, f-c, prly srted, subang-rnd			
35	50	sand, lt gry-lt brn, f-c, prly srted, subang-rnd, w/f to c gravel			

Site ID 00009953  
 MW11-flush mount cover

7 CONTRACTOR'S OR LANDOWNER'S CERTIFICATION: This water well was **(1)** constructed, **(2)** reconstructed, or **(3)** plugged under my jurisdiction and was completed on (mo/day/year) **10-25-93** and this record is true to the best of my knowledge and belief. Kansas Water Well Contractor's License No. **527** This Water Well Record was completed on (mo/day/yr) **01-29-94** under the business name of **GeoCore Services, Inc.** by (signature) *Paul A. Bell*