


WATER WELL RECORD Form WWC-5 KSA 82a-1212

1 LOCATION OF WATER WELL: County: **Ford** Fraction: **SE 1/4 SE 1/4 SW 1/4** Section Number: **26** Township Number: **T 26 S** Range Number: **R 25 EW**

Distance and direction from nearest town or city street address of well if located within city?
 Approx. 200' N & 10' E of the SE Corner of Trail & Santa Fe Streets, Dodge City, KS

2 WATER WELL OWNER: **Dodge City Cooperative Exchange** 52905124 MW-2
 RR#, St. Address, Box #: **710 West Trail Street, Box 610** Board of Agriculture, Division of Water Resources
 City, State, ZIP Code: **Dodge City, Kansas 67801** Application Number:

3 LOCATE WELL'S LOCATION WITH AN "X" IN SECTION BOX: 4 DEPTH OF COMPLETED WELL: **33.5** ft. ELEVATION: **Approx. Surface Elev. 2488**

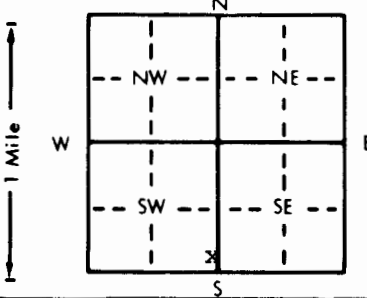

Depth(s) Groundwater Encountered 1. **22.5** ft. 2. _____ ft. 3. _____ ft.
 WELL'S STATIC WATER LEVEL **24.4** ft. below land surface measured on mo/day/yr **03/07/91**
 Pump test data: Well water was _____ ft. after _____ hours pumping _____ gpm
 Est. Yield **N/A** gpm: Well water was _____ ft. after _____ hours pumping _____ gpm
 Bore Hole Diameter **8.25** in. to **33.5** ft. and _____ in. to _____ ft.
 WELL WATER TO BE USED AS: 5 Public water supply 8 Air conditioning 11 Injection well
 1 Domestic 3 Feedlot 6 Oil field water supply 9 Dewatering 12 Other (Specify below)
 2 Irrigation 4 Industrial 7 Lawn and garden only Monitoring well
 Was a chemical/bacteriological sample submitted to Department? Yes _____ No If yes, mo/day/yr sample was submitted
 Water Well Disinfected? Yes _____ No

5 TYPE OF BLANK CASING USED: 1 Steel 3 RMP (SR) 5 Wrought iron 8 Concrete tile CASING JOINTS: Glued _____ Clamped _____
 PVC 4 ABS 7 Fiberglass 9 Other (specify below) Welded _____
 Threaded

Blank casing diameter **2** in. to **18** ft. Dia _____ in. to _____ ft. Dia _____ in. to _____ ft.
 Casing height above land surface **-5** in., weight _____ lbs./ft. Wall thickness or gauge No. **Schedule 40**

TYPE OF SCREEN OR PERFORATION MATERIAL: PVC 10 Asbestos-cement
 1 Steel 3 Stainless steel 5 Fiberglass 8 RMP (SR) 11 Other (specify) _____
 2 Brass 4 Galvanized steel 6 Concrete tile 9 ABS 12 None used (open hole)

SCREEN OR PERFORATION OPENINGS ARE: 5 Gauzed wrapped 8 Saw cut 11 None (open hole)
 1 Continuous slot Mill slot 6 Wire wrapped 9 Drilled holes
 2 Louvered shutter 4 Key punched 7 Torch cut 10 Other (specify) _____

SCREEN-PERFORATED INTERVALS: From **18** ft. to **33** ft. From _____ ft. to _____ ft.
 From _____ ft. to _____ ft. From _____ ft. to _____ ft.
 GRAVEL PACK INTERVALS: From **17** ft. to **33.5** ft. From _____ ft. to _____ ft.
 From _____ ft. to _____ ft. From _____ ft. to _____ ft.

6 GROUT MATERIAL: Neat cement 2 Cement grout Bentonite 4 Other _____
 Grout Intervals: From **0** ft. to **15** ft. From **15** ft. to **17** ft. From _____ ft. to _____ ft.

What is the nearest source of possible contamination:
 1 Septic tank 4 Lateral lines 7 Pit privy 10 Livestock pens 14 Abandoned water well
 2 Sewer lines 5 Cess pool 8 Sewage lagoon 11 Fuel storage 15 Oil well/Gas well
 3 Watertight sewer lines 6 Seepage pit 9 Feedyard 12 Fertilizer storage Other (specify below)
 13 Insecticide storage **Removed UST**
 Direction from well? **West/Southwest** How many feet? **270**

FROM	TO	LITHOLOGIC LOG	FROM	TO	PLUGGING INTERVALS
0	0.5'	Asphalt			
0.5'	11.0	Lean Clay with Sand, Brown			
11.0	15.0	Silty Sand, Light Brown			
15.0	23.5	Fine to Coarse Sand with Trace of Gravel, Brown			
23.5	31.5	Fine to Coarse Sand with Gravel, Brown			
31.5	33.5	Sandy Fat Clay, Pale Brown			

7 CONTRACTOR'S OR LANDOWNER'S CERTIFICATION: This water well was constructed, (2) reconstructed, or (3) plugged under my jurisdiction and was completed on (mo/day/year) **03/04/91** and this record is true to the best of my knowledge and belief. Kansas Water Well Contractor's License No. **416** This Water Well Record was completed on (mo/day/year) **5-24-91** under the business name of **Terracon Consultants, Inc.** by (signature) *Steve Fisher*

OFFICE USE ONLY
T
R
EW
SEC.