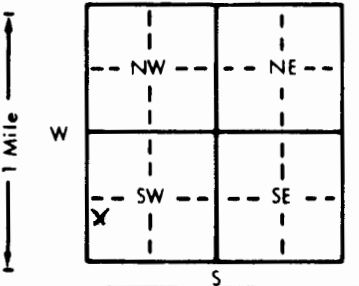


1 LOCATION OF WATER WELL:		Fraction NW 1/4 SW 1/4 SW 1/4		Section Number 26	Township Number T 26 S	Range Number R 25 EW
Distance and direction from nearest town or city street address of well if located within city? 1409 West Wyatt Earp Blvd. - Dodge City, Kansas						
2 WATER WELL OWNER: Coors of the Southwest RR#, St. Address, Box # : 1409 West Wyatt Earp Blvd. City, State, ZIP Code : Dodge City, Kansas 67801 Board of Agriculture, Division of Water Resources Application Number:						
3 LOCATE WELL'S LOCATION WITH AN "X" IN SECTION BOX:		4 DEPTH OF COMPLETED WELL: 43 ft. ELEVATION: 199.7				
		Depth(s) Groundwater Encountered 1. 165.87 ft. 2. ft. 3. ft.				
		WELL'S STATIC WATER LEVEL 33.81 ft. below land surface measured on mo/day/yr 11/2/92				
		Pump test data: Well water was ft. after hours pumping gpm				
		Est. Yield gpm: Well water was ft. after hours pumping gpm				
		Bore Hole Diameter 6 5/8 in. to 43 ft. and in. to ft.				
		WELL WATER TO BE USED AS:				
		1 Domestic 3 Feedlot 6 Oil field water supply 8 Air conditioning 11 Injection well				
		2 Irrigation 4 Industrial 7 Lawn and garden only 10 Monitoring well MW-1 12 Other (Specify below)				
		Was a chemical/bacteriological sample submitted to Department? Yes No X If yes, mo/day/yr sample was submitted				
		Water Well Disinfected? Yes No X				
5 TYPE OF BLANK CASING USED:						
1 Steel 3 RMP (SR) 5 Wrought iron 8 Concrete tile CASING JOINTS: Glued Clamped						
2 PVC 4 ABS 6 Asbestos-Cement 9 Other (specify below) Welded						
Blank casing diameter 2 in. to 40 ft., Dia in. to ft., Dia in. to ft.						
Casing height above land surface 0 in., weight lbs./ft. Wall thickness or gauge No. Sch. 40						
TYPE OF SCREEN OR PERFORATION MATERIAL:						
1 Steel 3 Stainless steel 5 Fiberglass 8 RMP (SR) 10 Asbestos-cement						
2 Brass 4 Galvanized steel 6 Concrete tile 9 ABS 11 Other (specify)						
12 None used (open hole)						
SCREEN OR PERFORATION OPENINGS ARE:						
1 Continuous slot 3 Mill slot 5 Gauzed wrapped 8 Saw cut 11 None (open hole)						
2 Louvered shutter 4 Key punched 6 Wire wrapped 9 Drilled holes						
7 Torch cut 10 Other (specify)						
SCREEN-PERFORATED INTERVALS: From 40 ft. to 30 ft., From ft. to ft.						
GRAVEL PACK INTERVALS: From 40 ft. to 27 ft., From ft. to ft.						
6 GROUT MATERIAL: 1 Neat cement 2 Cement grout 3 Bentonite 4 Other						
Grout Intervals: From 27 ft. to 23 ft., From 23 ft. to 0 ft., From ft. to ft.						
What is the nearest source of possible contamination:						
1 Septic tank 4 Lateral lines 7 Pit privy 10 Livestock pens 14 Abandoned water well						
2 Sewer lines 5 Cess pool 8 Sewage lagoon 11 Fuel storage 15 Oil well/Gas well						
3 Watertight sewer lines 6 Seepage pit 9 Feedyard 12 Fertilizer storage 16 Other (specify below)						
13 Insecticide storage						
Direction from well? How many feet? 250						
FROM		TO		LITHOLOGIC LOG		FROM TO PLUGGING INTERVALS
0		10		Concrete, Black Sandy Loam		
10		31		Sand, Tan, Fine to Med. Grained		
31		44		Sand, Tan, Med to Lg. Grained, Gravel, Small to Large.		
7 CONTRACTOR'S OR LANDOWNER'S CERTIFICATION: This water well was (1) constructed (2) reconstructed, or (3) plugged under my jurisdiction and was completed on (mo/day/year) 10/21/92 and this record is true to the best of my knowledge and belief. Kansas Water Contractor's License No. 540 This Water Well Record was completed on (mo/day/yr) 11/5/92 under the business name of Prairie Land Environmental Remediation, Inc (signature)						