WATER WELL RECORD Form WWC-5 KSA 82a-1212

1 LOCATION OF WATER WELL:	Fraction	Section Number	Township Number	Range Number
County: Ford	SW ¼ SE ¼ SE ¼	26	T 26 S	R 25 E (W)

Distance and direction from nearest town or city street address of well if located within city?

Lot #119 - Front Street, Dodge City, Ks.

2 WATER WELL OWNER: Dodge City Coop

RR#, St. Address, Box # : 710 West Trail

City, State, ZIP Code : Dodge City, Ks. 67801

MW# 4

Board of Agriculture, Division of Water Resources Application Number:

3 LOCATE WELL'S LOCATION WITH AN "X" IN SECTION BOX:

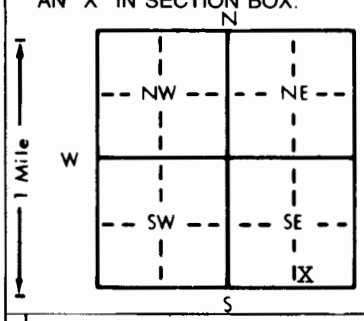

4 DEPTH OF ~~COMPLETED WELL~~ HOLE 23 ft. ELEVATION:

Depth(s) Groundwater Encountered 1. ft. 2. ft. 3. ft.

WELL'S STATIC WATER LEVEL N/A ft. below land surface measured on mo/day/yr

Pump test data: Well water was ft. after hours pumping gpm

Est. Yield gpm: Well water was ft. after hours pumping gpm

Bore Hole Diameter 7 5/8 in. to 23 ft., and in. to ft.

WELL WATER TO BE USED AS: 1 Domestic 2 Irrigation 3 Feedlot 4 Industrial 5 Public water supply 6 Oil field water supply 7 Lawn and garden only 8 Air conditioning 9 Dewatering 10 Monitoring well 11 Injection well (12) Other (Specify below) Test Boring

Was a chemical/bacteriological sample submitted to Department? Yes No; If yes, mo/day/yr sample was submitted Water Well Disinfected? Yes No

5 TYPE OF BLANK CASING USED: N/A 1 Steel 2 PVC 3 RMP (SR) 4 ABS 5 Wrought iron 6 Asbestos-Cement 7 Fiberglass 8 Concrete tile 9 Other (specify below)

CASING JOINTS: Glued Clamped Welded Threaded

Blank casing diameter in. to ft., Dia in. to ft., Dia in. to ft.

Casing height above land surface in., weight lbs./ft. Wall thickness or gauge No.

TYPE OF SCREEN OR PERFORATION MATERIAL: N/A 1 Steel 2 Brass 3 Stainless steel 4 Galvanized steel 5 Fiberglass 6 Concrete tile 7 PVC 8 RMP (SR) 9 ABS 10 Asbestos-cement 11 Other (specify) 12 None used (open hole)

SCREEN OR PERFORATION OPENINGS ARE: N/A 1 Continuous slot 2 Louvered shutter 3 Mill slot 4 Key punched 5 Gauzed wrapped 6 Wire wrapped 7 Torch cut 8 Saw cut 9 Drilled holes 10 Other (specify) 11 None (open hole)

SCREEN-PERFORATED INTERVALS: From N/A ft. to ft., From ft. to ft.

From ft. to ft., From ft. to ft.

GRAVEL PACK INTERVALS: From N/A ft. to ft., From ft. to ft.

From ft. to ft., From ft. to ft.

6 GROUT MATERIAL: 1 Neat cement 2 Cement grout 3 Bentonite 4 Other

Grout Intervals: From 2 ft. to 23 ft., From ft. to ft., From ft. to ft.

What is the nearest source of possible contamination:

1 Septic tank 2 Sewer lines 3 Watertight sewer lines 4 Lateral lines 5 Cess pool 6 Seepage pit 7 Pit privy 8 Sewage lagoon 9 Feedyard 10 Livestock pens 11 Fuel storage 12 Fertilizer storage 13 Insecticide storage 14 Abandoned water well 15 Oil well/Gas well 16 Other (specify below)

Direction from well? How many feet? Localized area

FROM	TO	LITHOLOGIC LOG	FROM	TO	PLUGGING INTERVALS
		Henkle Drilling & Supply Company augered a 7 5/8" hole to 23' and took split spoon samples & a water sample as noted on the attached log. We then plugged the bore hole.			

7 CONTRACTOR'S OR LANDOWNER'S CERTIFICATION: This water well was (1) constructed, (2) reconstructed, or (3) plugged under my jurisdiction and was completed on (mo/day/year) 2/21/90 and this record is true to the best of my knowledge and belief. Kansas Water Well Contractor's License No. 145 This Water Well Record was completed on (mo/day/yr) 3/14/90 under the business name of Henkle Drilling & Supply Co., Inc. by (signature) Douglas N. Henkle

INSTRUCTIONS: Use typewriter or ball point pen. *PLEASE PRESS FIRMLY* and *PRINT* clearly. Please fill in blanks, underline or circle the correct answers. Send top three copies to Kansas Department of Health and Environment, Bureau of Water, Topeka, Kansas 66620-7320. Telephone: 913-296-5545. Send one to WATER WELL OWNER and retain one for your records.

OFFICE USE ONLY T R E/W SEC. ¼ ¼ ¼

DRILLERS TEST LOG

CUSTOMER'S NAME: Servi-Tech (Dodge City Coop) DATE: 2/22/90
STREET ADDRESS: P. O. Box 1397 TEST # 4 E. LOG Augered 7
CITY & STATE: Dodge City, Ks. 67801 DRILLER Wildeman
COUNTY Ford QUARTER S½ SECTION 26 TOWNSHIP 26 RANGE 25

LOCATION West of Old Warehouse.

STATIC WATER LEVEL: 15?
Proposed Well Depth:

%	FOOTAGE From	Pay	TO	DESCRIPTION OF STRATA
	0		4"	Cement
	4"		2'	Fill
	2		6	Dark brown clay.
	6		8	Sand fine to medium.
	8		23	Sand fine to medium coarse. Small to large gravel (Very loose at 12').
				Split spoon samples 5' - 7' (25 knocks)
				10' - 12' (26 knocks)
				15' - 17' (7 knocks)
				Bailed a sample at 23'.
				Plugged well from bottom to 2'.
				9 sacks Hole plug.

GARDEN CITY, KS 67846 HENKLE DRILLING & SUPPLY CO., INC. 316-277-2389
3795 West Jones Ave.
IRRIGATION HEADQUARTERS

TEST HOLES * * * * * * * * * IRRIGATION & INDUSTRIAL WELLS * * * * * * * * * STOCK WELLS