

County: Ford Fraction: NW SW SW Sec. 28 T. 26 S R. 25 W

**CORRECTION(S) to WATER WELL COMPLETION RECORD Form WWC-5** (to rectify lacking or incorrect information)

Owner: Gerald Ring

If location corrected, was listed as:

Section-Township-Range: 28-26-25W

Fraction (1/4 calls): NW NW SW

Location changed to:

NW SW SW

Other changes: Initial statements: \_\_\_\_\_

Changed to: \_\_\_\_\_

Comments: \_\_\_\_\_

Verification method: Location of well as shown on driller's diagram on completion form, aerial images,  
and map showing railroad.

Submitted by: \_\_\_\_\_ Initials: SH Date: 04-03-2020

☒ Kansas Geological Survey, Data Resources Library, 1930 Constant Ave., Lawrence, KS 66047-3724

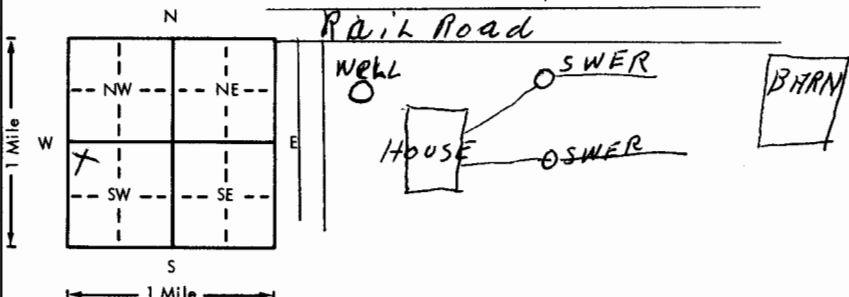
☐ Kansas Dept. of Health & Environment, Bureau of Water, 1000 SW Jackson, Suite 420, Topeka, KS 66612-1367

USE TYPEWRITER OR BALL  
POINT PEN-PRESS FIRMLY,  
PRINT CLEARLY.

WATER WELL RECORD  
KSA 82a-1201-1215

Kansas Department of Health and  
Environment-Division of Environment  
(Water well Contractors)  
Topeka, Kansas 66620

**C T B**

1. Location of well:		County <b>Ford</b>	Fraction <b>NW 1/4 NW 1/4 SW 1/4</b>	Section number <b>#28</b>	Township number <b>T #26 S</b>	Range number <b>R #25 W</b>																																	
2. Distance and direction from nearest town or city: <b>1 mile west on Highway 50 of Dodge City, Ks.</b> Street address of well location if in city:				3. Owner of well: <b>Gerald Ring</b> R.R. or street: <b>Hollywood Addn.</b> City, state, zip code: <b>Dodge City, Kansas 67801</b>																																			
4. Locate with "X" in section below: <div style="display: flex; align-items: center;"><div style="flex: 1;"><p>Sketch map:</p></div><div style="flex: 1; padding-left: 10px;">6. Bore hole dia. <b>8</b> in. Completion date <b>9-24-75</b> Well depth <b>185</b> ft.</div></div>				7. <input checked="" type="checkbox"/> Cable tool <input checked="" type="checkbox"/> Rotary <input type="checkbox"/> Driven <input type="checkbox"/> Dug <input type="checkbox"/> Hollow rod <input type="checkbox"/> Jetted <input type="checkbox"/> Bored <input type="checkbox"/> Reverse rotary																																			
5. Type and color of material				8. Use: <input checked="" type="checkbox"/> Domestic <input type="checkbox"/> Public supply <input type="checkbox"/> Industry <input type="checkbox"/> Irrigation <input type="checkbox"/> Air conditioning <input type="checkbox"/> Stock <input type="checkbox"/> Lawn <input type="checkbox"/> Oil field water <input type="checkbox"/> Other																																			
<table border="1" style="width: 100%; border-collapse: collapse;"><thead><tr><th></th><th>From</th><th>To</th></tr></thead><tbody><tr><td>Top soil &amp; clay</td><td>0</td><td>15</td></tr><tr><td>Clay &amp; coarse sand</td><td>15</td><td>30</td></tr><tr><td>Coarse sand</td><td>30</td><td>45</td></tr><tr><td>Coarse sand &amp; clay</td><td>45</td><td>60</td></tr><tr><td>Clay</td><td>60</td><td>75</td></tr><tr><td>Medium sand</td><td>75</td><td>90</td></tr><tr><td>Medium sand &amp; clay layers</td><td>90</td><td>135</td></tr><tr><td><del>Medium coarse sand</del></td><td>135</td><td>165</td></tr><tr><td><del>Medium to coarse sand &amp; clay</del></td><td>165</td><td>180</td></tr><tr><td><del>Clay &amp; blue shale</del></td><td>180</td><td>195</td></tr>clay</del>	165	180	<del>Clay &amp; blue shale</del>	180	195	9. Casing: Material <b>RMP</b> Height: Above or below <b>100</b> Threaded <input type="checkbox"/> Welded <input type="checkbox"/> Surface <b>12</b> in. RMP <input checked="" type="checkbox"/> PVC <input type="checkbox"/> Weight <b>12</b> lbs./ft. Dia. <b>5</b> in. to <b>185</b> ft. depth Wall Thickness: inches or Dia. <b>5</b> in. to <b>185</b> ft. depth gage No. <b>250</b>		
				10. Screen: Manufacturer's name <b>Sunflower</b> Type <b>RMP</b> Dia. <b>5</b> in. Slot/gauze <b>1/8</b> in. Length <b>20</b> ft. Set between <b>160</b> ft. and <b>180</b> ft. Gravel pack <b>yes</b> Size range of material <b>1/4</b> in.																																			
				11. Static water level: <b>35</b> ft. below land surface Date <b>9-24-75</b>																																			
				12. Pumping level below land surfaces: <b>40</b> ft. after <b>1 1/2</b> hrs. pumping <b>50</b> g.p.m. ____ ft. after ____ hrs. pumping ____ g.p.m. Estimated maximum yield <b>50</b> g.p.m.																																			
				13. Water sample submitted: ____ mo./day/yr. <input type="checkbox"/> Yes <input checked="" type="checkbox"/> No Date ____																																			
				14. Well head completion: <input checked="" type="checkbox"/> Pitless adapter <b>12</b> inches above grade																																			
				15. Well grouted? <b>yes</b> With: <input checked="" type="checkbox"/> Neat cement <input type="checkbox"/> Bentonite <input type="checkbox"/> Concrete Depth: From <b>4</b> ft. to <b>12</b> ft.																																			
				16. Nearest source of possible contamination: ft. <b>100</b> Direction <b>east</b> Type <b>sewer</b> Well disinfected upon completion? <input checked="" type="checkbox"/> Yes <input type="checkbox"/> No																																			
				17. Pump: <input type="checkbox"/> Not installed Manufacturer's name <b>Flint &amp; Walling</b> Model number <b>19BK5</b> HP <b>1/2</b> Volts <b>230</b> Length of drop pipe <b>84</b> ft. capacity <b>19</b> g.p.m. Type: <input checked="" type="checkbox"/> Submersible <input type="checkbox"/> Turbine <input type="checkbox"/> Jet <input type="checkbox"/> Reciprocating <input type="checkbox"/> Centrifugal <input type="checkbox"/> Other																																			
18. Elevation:				20. Water well contractor's certification: This well was drilled under my jurisdiction and this report is true to the best of my knowledge and belief. <b>JOE'S WELL SERVICE</b> <b>179</b> Business name License No. Address <b>Box 174 Cimarron, Ks.</b> Signed <b>Larry Crick</b> <b>12-20-75</b> Authorized representative Date																																			
19. Remarks: <b>TOPO</b>																																							

Forward the white, blue and pink copies to the Department of Health and Environment

Form WWC-5