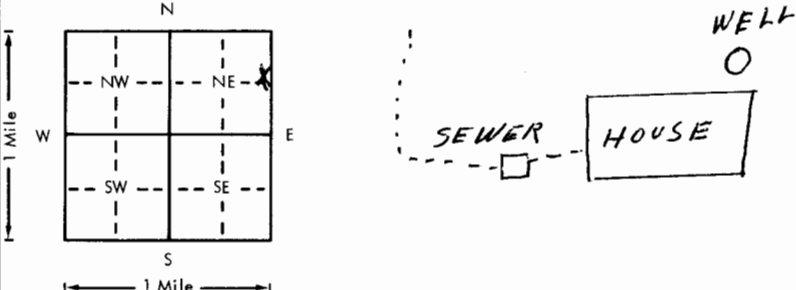


USE TYPEWRITER OR BALL
POINT PEN-PRESS FIRMLY,
PRINT CLEARLY.

WATER WELL RECORD
KSA 82a-1201-1215

Kansas Department of Health and
Environment-Division of Environment
(Water well Contractors)
Topeka, Kansas 66620

1. Location of well:	County Ford	Fraction NE 1/4 SE 1/4 NE 1/4	Section number 30	Township number T 26 S	Range number R 25 E/W
2. Distance and direction from nearest town or city: 3 1/2 miles west of Dodge City on highway 50 (north side of highway) Street address of well location if in city:			3. Owner of well: Dale Bayless R.R. or street: Route #2 City, state, zip code: Dodge City, Kansas 67801		
4. Locate with "X" in section below: 			6. Bore hole dia. 8 in. Completion date 11-17-76 Well depth 230 ft.		
5. Type and color of material			7. <input checked="" type="checkbox"/> Cable tool <input checked="" type="checkbox"/> Rotary <input type="checkbox"/> Driven <input type="checkbox"/> Dug <input type="checkbox"/> Hollow rod <input type="checkbox"/> Jetted <input type="checkbox"/> Bored <input type="checkbox"/> Reverse rotary		
Top soil & clay			8. Use: <input checked="" type="checkbox"/> Domestic <input type="checkbox"/> Public supply <input type="checkbox"/> Industry <input type="checkbox"/> Irrigation <input type="checkbox"/> Air conditioning <input type="checkbox"/> Stock <input type="checkbox"/> Lawn <input type="checkbox"/> Oil field water <input type="checkbox"/> Other		
Clay & medium to coarse sand			9. Casing: Material RMP Height: Above or Below Threaded <input type="checkbox"/> Welded <input type="checkbox"/> Surface 12 in. RMP <input checked="" type="checkbox"/> PVC <input type="checkbox"/> Weight 120 lbs./ft. Dia. 5 in. to 230 ft. depth Wall Thickness: inches or Dia. 5 in. to 230 ft. depth gage No. 250		
Coarse sand			10. Screen: Manufacturer's name Sunflower Type RMP Dia. 5" Slot 1/8" Length 20 ft. Set between 230 ft. and 230 ft. Gravel pack? yes Size range of material 1/2"		
Coarse sand to medium sand			11. Static water level: 80 ft. below land surface Date 11-17-76		
Medium to coarse sand dry			12. Pumping level below land surfaces: 90 ft. after 1 hrs. pumping 30 g.p.m. ft. after 1 hrs. pumping 30 g.p.m. Estimated maximum yield 50 g.p.m.		
Coarse to medium sand			13. Water sample submitted: yes mo./day/yr. <input type="checkbox"/> Yes <input checked="" type="checkbox"/> No Date 11-17-76		
Medium sand			14. Well head completion: <input checked="" type="checkbox"/> Pitless adapter 12 inches above grade		
Medium sand & clay layers			15. Well grouted? yes With: <input checked="" type="checkbox"/> Neat cement <input type="checkbox"/> Bentonite <input type="checkbox"/> Concrete Depth: From 5 ft. to 15 ft.		
Clay & fine sand			16. Nearest source of possible contamination: ft. 115 Direction West Type Sewer Well disinfected upon completion? <input checked="" type="checkbox"/> Yes <input type="checkbox"/> No		
Fine to medium sand			17. Pump: Manufacturer's name Aermotor Model number SD19-100 HP 1 Volts 230 Length of drop pipe 147 ft. capacity 19 g.p.m. Type: <input checked="" type="checkbox"/> Submersible <input type="checkbox"/> Turbine <input type="checkbox"/> Jet <input type="checkbox"/> Reciprocating <input type="checkbox"/> Centrifugal <input type="checkbox"/> Other		
Medium sand			20. Water well contractor's certification: This well was drilled under my jurisdiction and this report is true to the best of my knowledge and belief. JOE'S WELL SERVICE 179 Business name License No. Address Box 174 Cimarron, Ks. Signed Larry S. Crick Date 1-31-77 Authorized representative		
Medium to coarse sand					
Coarse sand					
Clay & blue shale					
18. Elevation:			19. Remarks: Well has excellent drainage to the West 80 750 sat above 25-11 230 151		

Forward the white, blue and pink copies to the Department of Health and Environment

Form WWC-5