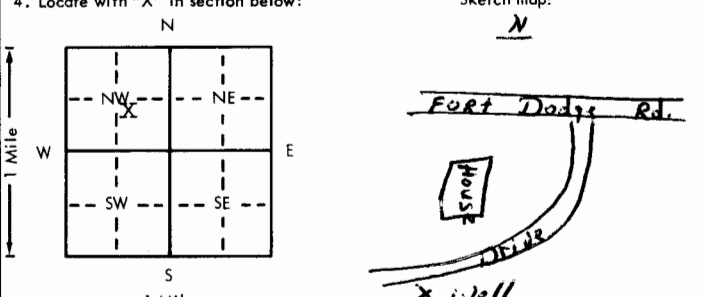


USE TYPEWRITER OR BALL
POINT PEN-PRESS FIRMLY,
PRINT CLEARLY.

WATER WELL RECORD
KSA 82a-1201-1215

Kansas Department of Health and
Environment-Division of Environment
(Water well Contractors)
Topeka, Kansas 66620

1. Location of well:		County Ford	Fraction NW 1/4 SE NW NW 1/4	Section number 36	Township number T 26 S	Range number R 25 E
2. Distance and direction from nearest town or city: East on Fort Dodge Road from Dodge City, Kansas			3. Owner of well: Ray Wessel R.R. or street: Fort Dodge Road City, state, zip code: Dodge City, Kansas 67801			
4. Locate with "X" in section below: 			6. Bore hole dia. 9 in. Completion date 2-17-77 Well depth 139 ft.			
5. Type and color of material			7. <input checked="" type="checkbox"/> Cable tool <input checked="" type="checkbox"/> Rotary <input type="checkbox"/> Driven <input type="checkbox"/> Dug <input type="checkbox"/> Hollow rod <input type="checkbox"/> Jetted <input type="checkbox"/> Bored <input type="checkbox"/> Reverse rotary			
Surface			8. Use: <input type="checkbox"/> Domestic <input type="checkbox"/> Public supply <input type="checkbox"/> Industry <input type="checkbox"/> Irrigation <input type="checkbox"/> Air conditioning <input type="checkbox"/> Stock <input checked="" type="checkbox"/> Lawn <input type="checkbox"/> Oil field water <input type="checkbox"/> Other			
Brown clay			9. Casing: Material plastic Height: Above or below Threaded <input type="checkbox"/> Welded <input checked="" type="checkbox"/> Surface 12 in. RMP <input checked="" type="checkbox"/> PVC <input type="checkbox"/> Weight 1.8 lbs./ft. Dia. 5 in. to 139 ft. depth Wall Thickness: inches or Dia. <input type="checkbox"/> in. to <input type="checkbox"/> ft. depth gage No. 0-220			
Medium sand and gravel			10. Screen: Manufacturer's name Jess and Lowell Type RMP Dia. 5" Slot/gauze 1/16 Length 49' Set between 99 ft. and 139 ft. ft. and 1-1/8 ft.			
50% fine sand mixed with clay			11. Static water level: 28 ft. below land surface Date 2-18-77 mo./day/yr.			
Sandy brown clay			12. Pumping level below land surfaces: ft. after <input type="checkbox"/> hrs. pumping <input type="checkbox"/> g.p.m. ft. after <input type="checkbox"/> hrs. pumping <input type="checkbox"/> g.p.m. Estimated maximum yield <input type="checkbox"/> g.p.m.			
Good fine to medium sand and gravel			13. Water sample submitted: <input checked="" type="checkbox"/> Yes <input type="checkbox"/> No Date <input type="checkbox"/>			
gravel			14. Well head completion: <input type="checkbox"/> Pitless adapter <input type="checkbox"/> Inches above grade			
Rock 15'			15. Well grouted? yes With: <input type="checkbox"/> Neat cement <input checked="" type="checkbox"/> Bentonite <input type="checkbox"/> Concrete Depth: From 0 ft. to 13 ft.			
78' sand 14'			16. Nearest source of possible contamination: ft. <input type="checkbox"/> Direction <input type="checkbox"/> Type House Well disinfected upon completion? <input checked="" type="checkbox"/> Yes <input type="checkbox"/> No			
11' sand 14'			17. Pump: <input checked="" type="checkbox"/> Not installed Manufacturer's name <input type="checkbox"/> Model number <input type="checkbox"/> HP <input type="checkbox"/> Volts <input type="checkbox"/> Length of drop pipe <input type="checkbox"/> ft. capacity <input type="checkbox"/> g.p.m. Type: <input type="checkbox"/> Submersible <input type="checkbox"/> Turbine <input type="checkbox"/> Jet <input type="checkbox"/> Reciprocating <input type="checkbox"/> Centrifugal <input type="checkbox"/> Other			
11' sand 14'			20. Water well contractor's certification: This well was drilled under my jurisdiction and this report is true to the best of my knowledge and belief. Hodde Drilling Co. 302 Business name R.R. #1 Dodge City, KS Address W. R. #1 Dodge City, KS Signed Willie Hodde Jr. Date 2-10-77 Authorized representative			
18. Elevation:			19. Remarks: 2472 1015			
Topography: <input checked="" type="checkbox"/> Hill <input checked="" type="checkbox"/> Slope <input type="checkbox"/> Upland <input type="checkbox"/> Valley						

Forward the white, blue and pink copies to the Department of Health and Environment

Form WWC-5