WATER WELL RECORD Form WWC-5 KSA 82a-1212

1 LOCATION OF WATER WELL: County: FORD | Fraction: NW¼ NW¼ SW¼ | Section Number: 36 | Township Number: T 26 S | Range Number: R 25 E(W)

Distance and direction from nearest town or city street address of well if located within city?
815 CLARK DODGE CITY, KS.

2 WATER WELL OWNER: DWAYNE PERKINS
RR#, St. Address, Box # : 815 CLARK
City, State, ZIP Code : DODGE CITY, KS. 67801
Board of Agriculture, Division of Water Resources
Application Number:

3 LOCATE WELL'S LOCATION WITH AN "X" IN SECTION BOX:

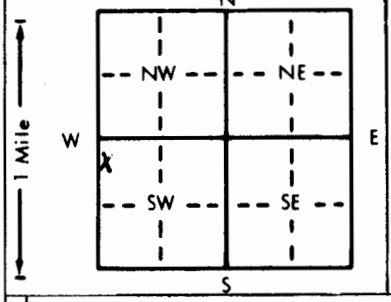

4 DEPTH OF COMPLETED WELL 166 ft. ELEVATION:
Depth(s) Groundwater Encountered 1. 22 ft. 2. 118 ft. 3. ft.
WELL'S STATIC WATER LEVEL 59 ft. below land surface measured on mo/day/yr 6-18-83
Pump test data: Well water was ft. after hours pumping gpm
Est. Yield gpm: Well water was ft. after hours pumping gpm
Bore Hole Diameter 9 in. to 166 ft., and in. to ft.
WELL WATER TO BE USED AS: 5 Public water supply 8 Air conditioning 11 Injection well
1 Domestic 3 Feedlot 6 Oil field water supply 9 Dewatering 12 Other (Specify below)
2 Irrigation 4 Industrial 7 Lawn and garden only 10 Observation well
Was a chemical/bacteriological sample submitted to Department? Yes No X; If yes, mo/day/yr sample was submitted
Water Well Disinfected? Yes X No

5 TYPE OF BLANK CASING USED: 5 Wrought iron 8 Concrete tile CASING JOINTS: Glued X Clamped
1 Steel 3 RMP (SR) 6 Asbestos-Cement 9 Other (specify below) Welded
2 PVC 4 ABS 7 Fiberglass Threaded
Blank casing diameter 5 in. to 166 ft., Dia in. to ft., Dia in. to ft.
Casing height above land surface 18" in., weight 1.60 lbs./ft. Wall thickness or gauge No. 160 Jet Stream

TYPE OF SCREEN OR PERFORATION MATERIAL: 7 PVC 10 Asbestos-cement
1 Steel 3 Stainless steel 5 Fiberglass 8 RMP (SR) 11 Other (specify)
2 Brass 4 Galvanized steel 6 Concrete tile 9 ABS 12 None used (open hole)

SCREEN OR PERFORATION OPENINGS ARE: 5 Gauzed wrapped 8 Saw cut 11 None (open hole)
1 Continuous slot 3 Mill slot 6 Wire wrapped 9 Drilled holes
2 Louvered shutter 4 Key punched 7 Torch cut 10 Other (specify)

SCREEN-PERFORATED INTERVALS: From 136 ft. to 166 ft., From ft. to ft.
From ft. to ft., From ft. to ft.
GRAVEL PACK INTERVALS: From 130 ft. to 166 ft., From ft. to ft.
From 20 ft. to 120 ft., From ft. to ft.

6 GROUT MATERIAL: 1 Neat cement 2 Cement grout 3 Bentonite 4 Other
Grout Intervals: From 120 ft. to 130 ft., From 10 ft. to 20 ft., From 3 ft. to 5 ft.

What is the nearest source of possible contamination:
1 Septic tank 4 Lateral lines 7 Pit privy 10 Livestock pens 14 Abandoned water well
2 Sewer lines 5 Cess pool 8 Sewage lagoon 11 Fuel storage 15 Oil well/Gas well
3 Watertight sewer lines 6 Seepage pit 9 Feedyard 12 Fertilizer storage 16 Other (specify below)
13 Insecticide storage
Direction from well? north east How many feet? 56

FROM	TO	LITHOLOGIC LOG	FROM	TO	LITHOLOGIC LOG
0	22	Fine Sand			
22	45	Coarse Gravel			
45	42	Clay + Sand			
42	103	Clay + 20% Fine sand			
103	136	Fine sand 10% clay			
136	166	Coarse Gravel			
166		Blue Shale			

7 CONTRACTOR'S OR LANDOWNER'S CERTIFICATION: This water well was (1) constructed, (2) reconstructed, or (3) plugged under my jurisdiction and was completed on (mo/day/year) 6-17-83 and this record is true to the best of my knowledge and belief. Kansas Water Well Contractor's License No. 423 This Water Well Record was completed on (mo/day/yr) 6-13-83 under the business name of Cline Drilling Co. by (signature) Jack D. Cline

INSTRUCTIONS: Use typewriter or ball point pen, *PLEASE PRESS FIRMLY* and *PRINT* clearly. Please fill in blanks, underline or circle the correct answers. Send top three copies to Kansas Department of Health and Environment, Division of Environment, Environmental Geology Section, Topeka, KS 66620. Send one to WATER WELL OWNER and retain one for your records.

JUL 1 43

OFFICE USE ONLY T 26 R 25 E(W) SEC. 36 NW¼ NW¼ SW¼