


1 LOCATION OF WATER WELL: Fraction NE 1/4 NW 1/4 NE 1/4 Section Number 36 Township Number T 26 S Range Number R 25 EW
 County: Fora
 Distance and direction from nearest town or city street address of well if located within city?

600 East Trail - Dodge City, KS 67801

2 WATER WELL OWNER: Safety-Kleen
 RR#, St. Address, Box # :
 City, State, ZIP Code : (See above)
 Board of Agriculture, Division of Water Resources
 Application Number: N/A

3 LOCATE WELL'S LOCATION WITH AN "X" IN SECTION BOX:

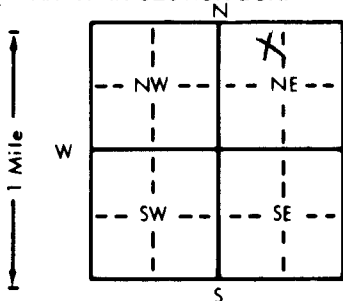

4 DEPTH OF COMPLETED WELL: 30.1 ft. ELEVATION: GL

Depth(s) Groundwater Encountered 1. 19.6 ft. 2. 19.6 ft. 3. 19.6 ft.

WELL'S STATIC WATER LEVEL 19.6 ft. below land surface measured on mo/day/yr 3/2/90

Pump test data: Well water was N/A ft. after N/A hours pumping N/A gpm

Est. Yield N/A gpm: Well water was N/A ft. after N/A hours pumping N/A gpm


WELL WATER TO BE USED AS: 5 Public water supply 8 Air conditioning 11 Injection well

1 Domestic 3 Feedlot 6 Oil field water supply 9 Dewatering 12 Other (Specify below)

2 Irrigation 4 Industrial 7 Lawn and garden only 10 Monitoring well

Was a chemical/bacteriological sample submitted to Department? Yes No; If yes, mo/day/yr sample was submitted

Water Well Disinfected? Yes No

5 TYPE OF BLANK CASING USED: 5 Wrought iron 8 Concrete tile CASING JOINTS: Glued Clamped

1 Steel 3 RMP (SR) 6 Asbestos-Cement 9 Other (specify below) Welded Threaded

2 PVC 4 ABS 7 Fiberglass


Casing height above land surface GL in., weight GL lbs./ft. Wall thickness or gauge No. Sch 40

TYPE OF SCREEN OR PERFORATION MATERIAL: 7 PVC 10 Asbestos-cement

1 Steel 2 Stainless steel 5 Fiberglass 8 RMP (SR) 11 Other (specify)

2 Brass 4 Galvanized steel 6 Concrete tile 9 ABS 12 None used (open hole)

SCREEN OR PERFORATION OPENINGS ARE: 5 Gauzed wrapped 8 Saw cut 11 None (open hole)

1 Continuous slot 3 Mill slot 6 Wire wrapped 9 Drilled holes

2 Louvered shutter 4 Key punched 7 Torch cut 10 Other (specify)

SCREEN-PERFORATED INTERVALS: From 10.1 ft. to 30.1 ft. From 10.1 ft. to 30.1 ft.

From 10.1 ft. to 30.1 ft. From 10.1 ft. to 30.1 ft.

GRAVEL PACK INTERVALS: From 7.0 ft. to 30.1 ft. From 7.0 ft. to 30.1 ft.

From 7.0 ft. to 30.1 ft. From 7.0 ft. to 30.1 ft.

6 GROUT MATERIAL: 1 Neat cement 2 Cement grout 3 Bentonite 4 Other

Grout Intervals: From 0 ft. to 5 ft. From 0 ft. to 5 ft.

What is the nearest source of possible contamination: 10 Livestock pens 14 Abandoned water well

1 Septic tank 4 Lateral lines 7 Pit privy 11 Fuel storage 15 Oil well/Gas well

2 Sewer lines 5 Cess pool 8 Sewage lagoon 12 Fertilizer storage 16 Other (specify below)

3 Watertight sewer lines 6 Seepage pit 9 Feedyard 13 Insecticide storage Hydro Carbon Spill (on site)

Direction from well? How many feet?

FROM	TO	LITHOLOGIC LOG	FROM	TO	PLUGGING INTERVALS
0	2.0	top soil			
2.0	4.5	Clay			
4.5	7.0	Clay / loam			
7.0	9.5	Clay w/ interbedded Sand			
9.5	12.0	Tan Coarse Sand w/ pebbles			
12.0	14.5	Med - Coarse Sand w/ gravel			
14.5	17.0	gravel w/ pebbles & Coarse Sand			
17.0	19.5	(Same)			
19.5	22.0	gravel w/ 1" pebbles			
22.0	24.5	(Same)			
24.5	27.0	gravel w/ Sand			
27.0	31.0	Clay			

7 CONTRACTOR'S OR LANDOWNER'S CERTIFICATION: This water well was (1) constructed, (2) reconstructed, or (3) plugged under my jurisdiction and was completed on (mo/day/year) 3/2/90 and this record is true to the best of my knowledge and belief. Kansas

Water Well Contractor's License No. 102 This Water Well Record was completed on (mo/day/yr) 3/23/90

under the business name of Layne Western Co. Inc. by (signature)