

CORRECTION(S) TO WATER WELL RECORD (WWC-5)

(to rectify lacking or incorrect information)

County: Fond

Location listed as:

Section-Township-Range: 26-T26S-R21WFraction ($\frac{1}{4}$ $\frac{1}{4}$ $\frac{1}{4}$): SE NW SE

Location changed to:

36-T26S-R25WNE NW NEOther changes: Initial statements: Several Monitoring wells located in rural Fond County
were clearly in wrong locationChanged to: Moved to Dodge City to match existing set of SafetyKleen
wells.Comments: Numbers of wells mis-located matched series located in town

verification method: _____

initials: DAH date: Apr 27, 2007

1 LOCATION OF WATER WELL:

County: Ford Fraction SE 1/4 NW 1/4 SE 1/4 Section Number 26 Township Number T 27 S Range Number R 21 E

Distance and direction from nearest town or city street address of well if located within city?

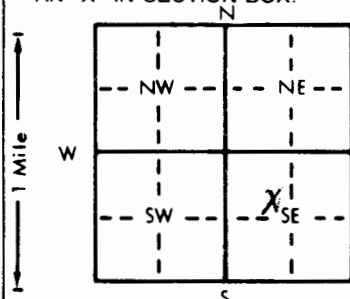
2 WATER WELL OWNER:

RR#, St. Address, Box # : SAFETY KLEEN
777 B.S. Timber
City, State, ZIP Code : ELGIN ILL. 60123

Board of Agriculture, Division of Water Resources

Application Number:

3 LOCATE WELL'S LOCATION WITH AN "X" IN SECTION BOX:


WELL WATER TO BE USED AS: 5 Public water supply 8 Air conditioning 11 Injection well


5 TYPE OF BLANK CASING USED:


TYPE OF SCREEN OR PERFORATION MATERIAL:

1 Steel 3 Stainless steel 5 Fiberglass 8 RMP (SR) 10 Asbestos-cement

2 Brass 4 Galvanized steel 6 Concrete tile 9 ABS 11 Other (specify) 23

SCREEN OR PERFORATION OPENINGS ARE: 5 Gauzed wrapped 8 Saw cut 11 None (open hole)

1 Continuous slot 3 Mill slot 6 Wire wrapped 9 Drilled holes



What is the nearest source of possible contamination: 10 Livestock pens 14 Abandoned water well

1 Septic tank 4 Lateral lines 7 Pit privy 11 Fuel storage 15 Oil well/Gas well

2 Sewer lines 5 Cess pool 8 Sewage lagoon 12 Fertilizer storage 16 Other (specify below)

3 Watertight sewer lines 6 Seepage pit 9 Feedyard 13 Insecticide storage 23 Solvent tankDirection from well? South How many feet? 23

FROM TO LITHOLOGIC LOG FROM TO PLUGGING INTERVALS

22 3 Well over drilled + casing pulled out22 3 Bentonite

7 CONTRACTOR'S OR LANDOWNER'S CERTIFICATION: This water well was (1) constructed, (2) reconstructed, or (3) plugged under my jurisdiction and was

completed on (mo/day/year) 12-3-90 and this record is true to the best of my knowledge and belief. KansasWater Well Contractor's License No. 416 This Water Well Record was completed on (mo/day/yr) 6-21-91under the business name of Ferracan Consultants by (signature) Ed M. Kautz