

CORRECTION(S) TO WATER WELL RECORD (WWC-5)  
(to rectify lacking or incorrect information)

Location listed as:

Section-Township-Range: 35-T27S-R25W

Fraction (  $\frac{1}{4}$   $\frac{1}{4}$   $\frac{1}{4}$  ): SE SE SE

County: Ford

Location changed to:

35-T26S-R25W

SE SE SE

Other changes: Initial statements: Several monitoring wells in Dodge City were  
mis-located 6 miles South

Changed to: T26S

Comments:

verification method: WWCS database and mapquest website

initials: DAH date: June 9, 2005

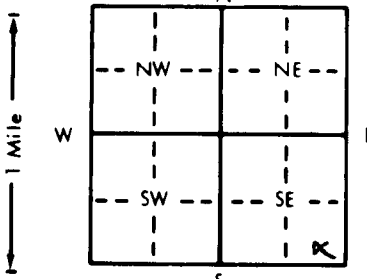
submitted by: Kansas Geological Survey, Data Resources Library, 1930 Constant Ave., Lawrence, KS 66047-3726  
to: Kansas Dept of Health & Environment, Bureau of Water, 1000 SW Jackson, Suite 420, Topeka, KS 66612-1367.

1 LOCATION OF WATER WELL: County: <b>FORD</b> <b>029</b> Fraction <b>SE 1/4 SE 1/4 SE 1/4</b> Section Number <b>35</b> Township Number <b>T 27 S</b> Range Number <b>R 25 EW</b>
---

Distance and direction from nearest town or city street address of well if located within city?

**20' W, 20' S OF SW CORNER BLDG 718 S. SECOND ST.****OB-1**

2 WATER WELL OWNER: <b>SOUTHWEST OIL</b> RR#, St. Address, Box # : <b>PO BOX 116</b> City, State, ZIP Code : <b>DODGE CITY, KS 67801</b>	Board of Agriculture, Division of Water Resources Application Number:
---	--------------------------------------------------------------------------

3 LOCATE WELL'S LOCATION WITH AN "X" IN SECTION BOX: 	4 DEPTH OF COMPLETED WELL: <b>25'</b> ft. ELEVATION: Depth(s) Groundwater Encountered 1. <b>20.3</b> ft. 2. ft. 3. ft. WELL'S STATIC WATER LEVEL <b>20.3</b> ft. below land surface measured on mo/day/yr <b>4-17-91</b> Pump test data: Well water was ft. after hours pumping gpm Est. Yield gpm: Well water was ft. after hours pumping gpm Bore Hole Diameter in. to ft., and in. to ft. WELL WATER TO BE USED AS: 5 Public water supply 8 Air conditioning 11 Injection well 1 Domestic 3 Feedlot 6 Oil field water supply 9 Dewatering 12 Other (Specify below) 2 Irrigation 4 Industrial 7 Lawn and garden only <b>10 Monitoring well</b> Was a chemical/bacteriological sample submitted to Department? Yes <b>No</b> ; If yes, mo/day/yr sample was submitted Water Well Disinfected? Yes <b>No</b>
---	---

5 TYPE OF BLANK CASING USED: 1 Steel 3 RMP (SR) 5 Wrought iron 8 Concrete tile <b>2 PVC</b> 4 ABS 6 Asbestos-Cement 9 Other (specify below) Blank casing diameter <b>2</b> in. to <b>15</b> ft., Dia. in. to ft., Dia. in. to ft. Casing height above land surface <b>3</b> in., weight lbs./ft. Wall thickness or gauge No. <b>40</b> TYPE OF SCREEN OR PERFORATION MATERIAL: 1 Steel 3 Stainless steel 5 Fiberglass 8 RMP (SR) 10 Asbestos-cement 2 Brass 4 Galvanized steel 6 Concrete tile 9 ABS 11 Other (specify) 12 None used (open hole) SCREEN OR PERFORATION OPENINGS ARE: 1 Continuous slot 3 Mill slot 5 Gauzed wrapped 8 Saw cut 11 None (open hole) 2 Louvered shutter 4 Key punched 6 Wire wrapped 9 Drilled holes 7 Torch cut 10 Other (specify) SCREEN-PERFORATED INTERVALS: From <b>15</b> ft. to <b>25</b> ft., From ft. to ft. GRAVEL PACK INTERVALS: From <b>13</b> ft. to <b>25</b> ft., From ft. to ft. From ft. to ft., From ft. to ft.	CASING JOINTS: Glued Clamped <b>Welded</b> <b>Threaded</b>
---	------------------------------------------------------------------

6 GROUT MATERIAL: 1 Neat cement 2 Cement grout 3 Bentonite 4 Other Grout Intervals: From <b>3</b> <b>13</b> ft. to <b>10</b> ft., From <b>2</b> <b>10</b> ft. to <b>0</b> ft., From ft. to ft. What is the nearest source of possible contamination: 1 Septic tank 4 Lateral lines 7 Pit privy 10 Livestock pens 14 Abandoned water well 2 Sewer lines 5 Cess pool 8 Sewage lagoon 11 Fuel storage 15 Oil well/Gas well 3 Watertight sewer lines 6 Seepage pit 9 Feedyard 12 Fertilizer storage 16 Other (specify below) 13 Insecticide storage Direction from well? <b>W</b> How many feet? <b>30</b>
---

FROM	TO	LITHOLOGIC LOG	FROM	TO	PLUGGING INTERVALS
<b>0</b>	<b>4</b>	<b>04 SANDY CLAY</b>			
<b>4</b>	<b>9</b>	<b>01 CLAY</b>			<del>GROUT VARIANCE GRANTED</del>
<b>9</b>	<b>25</b>	<b>05 SAND</b>			<del>CASING HT. VARIANCE GRANTED</del>
					<b>GROUT VARIANCE GRANTED</b>
					<b>CASING HT. VARIANCE GRANTED</b>

7 CONTRACTOR'S OR LANDOWNER'S CERTIFICATION: This water well was (1) constructed, (2) reconstructed, or (3) plugged under my jurisdiction and was completed on (mo/day/year) <b>4-17-91</b> and this record is true to the best of my knowledge and belief. Kansas Water Well Contractor's License No. <b>517</b> This Water Well Record was completed on (mo/day/yr) <b>5-1-91</b> under the business name of <b>GROUNDWATER TECHNOLOGY</b> by (signature) <b>Albert Stout</b>
---

INSTRUCTIONS: Use typewriter or ball point pen. PLEASE PRESS FIRMLY and PRINT clearly. Please fill in blanks, underline or circle the correct answers. Send top three copies to Kansas Department of Health and Environment, Bureau of Water, Topeka, Kansas 66620-7320. Telephone: 913-296-5545. Send one to WATER WELL OWNER and retain one for your records.

8120021006-22