

## CORRECTION(S) TO WATER WELL RECORD (WWC-5)

(to rectify lacking or incorrect information)

County: Ford

Location listed as:

Section-Township-Range: 5, T29S, R26WFraction (  $\frac{1}{4}$   $\frac{1}{4}$   $\frac{1}{4}$ ): NE NE

Location changed to:

Sec. 28, T. 26 S., R25 WSW 8W SW

Other changes: Initial statements: If location is correct, then directions are  
very wrong. Location puts well in western Ford County.

Changed to: \_\_\_\_\_

Comments: New location based on guess on where these lots are  
located on West. Park Sr., Dodge City

verification method: \_\_\_\_\_

initials: DMH date: Nov. 6, 2007

LOCATION OF WATER WELL:		Fraction	Section	Number	Township Number	Range Number
County:	Ford	$\frac{1}{4}$ NE $\frac{1}{4}$ NE $\frac{1}{4}$	5		T 29 S	R 26 EW


LOCATION OF WATER WELL:		Fraction	Section	Number	Township Number	Range Number
County:	Ford	$\frac{1}{4}$ NE $\frac{1}{4}$ NE $\frac{1}{4}$	5		T 29 S	R 26 EW

Distance and direction from nearest town or city street address of well if located within city?

Lots 1 & 2 on West Park Street - Dodge City, Ks

2	WATER WELL OWNER:	Kenny Masten	
	RR#, St. Address, Box # :	708 10th Ave.	Board of Agriculture, Division of Water Resources
	City, State, ZIP Code :	Dodge City, Kansas 67801	Application Number:

LOCATE WELL'S LOCATION WITH AN "X" IN SECTION BOX: 4 DEPTH OF COMPLETED WELL.....165..... ft. ELEVATION: .....

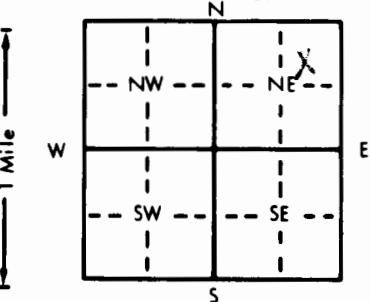

Depth(s) Groundwater Encountered 1. .... ft. 2. .... ft. 3. .... ft.

WELL'S STATIC WATER LEVEL ...24... ft. below land surface measured on mo/day/yr ...9-21-88

Pump test data: Well water was ..... ft. after ..... hours pumping ..... gpm

Est. Yield ...80... gpm: Well water was ..... ft. after ..... hours pumping ..... gpm

Bore Hole Diameter ...8... in. to ...165... ft., and ..... in. to ..... ft.

WELL WATER TO BE USED AS:

1 Domestic	3 Feedlot	6 Oil field water supply	9 Dewatering	11 Injection well
2 Irrigation	4 Industrial	7 Lawn and garden only	10 Observation well	12 Other (Specify below)

Was a chemical/bacteriological sample submitted to Department? Yes.....No....XX....; If yes, mo/day/yr sample was submitted

Water Well Disinfected? Yes XX No

TYPE OF BLANK CASING USED:		5 Wrought iron	8 Concrete tile	CASING JOINTS: Glued .XX. Clamped .
1 Steel	3 RMP (SR)	6 Asbestos-Cement	9 Other (specify below)	Welded .
2 PVC	4 ABS	7 Fiberglass		Threaded .
Blank casing diameter .5. in. to .165. ft. Dia .				in. to . ft. Dia .
Casing height above land surface .12. in. weight .200 psi		lbs./ft. Wall thickness or gauge No. SDR 21		

TYPE OF SCREEN OR PERFORATION MATERIAL:			7 <u>PVC</u>	10 Asbestos-cement
1 Steel	3 Stainless steel	5 Fiberglass	8 RMP (SR)	11 Other (specify) .....
2 Brass	4 Galvanized steel	6 Concrete tile	9 ABS	12 None used (open hole)

SCREEN OR PERFORATION OPENINGS ARE:		5 Gauzed wrapped	8 Saw cut	11 None (open hole)
1 Continuous slot	3 Mill slot	6 Wire wrapped	9 Drilled holes	
2 Louvered shutter	4 Key punched	7 Torch cut	10 Other (specify) .....	
SCREEN-PERFORATED INTERVALS:	From . . . . 140 . . . . .	ft. to . . . 160 . . . . .	ft. From . . . . .	ft. to . . . . .
	From . . . . .	ft. to . . . . .	ft. From . . . . .	ft. to . . . . .
GRAVEL PACK INTERVALS:	From . . . . 60 . . . . .	ft. to . . . 165 . . . . .	ft. From . . . . .	ft. to . . . . .
	From . . . . .	ft. to . . . . .	ft. From . . . . .	ft. to . . . . .

3 GROUT MATERIAL: 1 Neat cement 2 Cement grout 3 Bentonite 4 Other .. & hole plug .....

Grout Intervals: From 5 ft. to 60 ft. From ft. to ft. From ft. to ft.

What is the nearest source of possible contamination:

1 Septic tank	4 Lateral lines	7 Pit privy	10 Livestock pens	14 Abandoned water well
2 Sewer lines	5 Cess pool	8 Sewage lagoon	11 Fuel storage	15 Oil well/Gas well
3 Watertight sewer lines	6 Seepage pit	9 Feedyard	12 Fertilizer storage	16 Other (specify below)
13 Insecticide storage				

Direction from well? Northwest

How many feet? 80

[illegible]

CONTRACTOR'S OR LANDOWNER'S CERTIFICATION: This water well was (1) constructed, (2) reconstructed, or (3) plugged under my jurisdiction and was completed on (mo/day/year) 9-22-88 and this record is true to the best of my knowledge and belief. Kansas Water Well Contractor's License No. 179 This Water Well Record was completed on (mo/day/yr) 105-88 under the business name of Joe's Well Service, Inc. Cimarron, Ks. by (signature) David Pink

INSTRUCTIONS: Use typewriter or ball point pen. PLEASE PRESS FIRMLY and PRINT clearly. Please fill in blanks, underline or circle the correct answers. Send top three copies to Kansas Department of Health and Environment, Bureau of Water Protection, Topeka, Kansas 66620-7320, Telephone: 913-862-9360. Send one to WATER WELL OWNER and retain one for your records.