

CORRECTION(S) TO WATER WELL RECORD (WWC-5)

(to rectify lacking or incorrect information)

Location listed as:

County: Ford

Location changed to:

Section-Township-Range: 35-T27S-R25W

35-T26S-R25W

Fraction ($\frac{1}{4}$ $\frac{1}{4}$ $\frac{1}{4}$): NE SW SE

NE SW SE

Other changes: Initial statements: Several monitoring wells in Dodge City were
mis-located 6 miles South

Changed to: T26S

Comments: _____

verification method: WWC5 database and MapQuest website

initials: DAM date: June 9, 2005


007263

CM2540

1] LOCATION OF WATER WELL: Fraction NE 1/4 SW 1/4 SE 1/4 Section Number 35 Township Number T 27 S Range Number R 25 EW
 County: Ford

Distance and direction from nearest town or city street address of well if located within city?
609 S. Second, Dodge City

2] WATER WELL OWNER: Coastal Mart, Inc. Board of Agriculture, Division of Water Resources
 RR#, St. Address, Box #: Nine Greenway Plaza Application Number:
 City, State, ZIP Code: Houston TX 77046

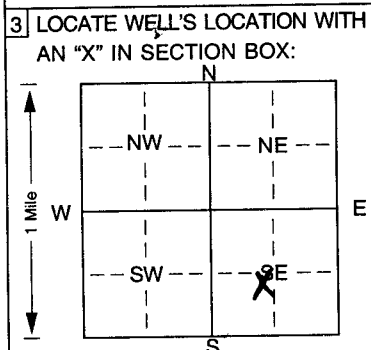

4] DEPTH OF COMPLETED WELL: 25 ft. ELEVATION: _____
 Depth(s) Groundwater Encountered 1. _____ ft. 2. _____ ft. 3. _____ ft.
 WELL'S STATIC WATER LEVEL _____ ft. below land surface measured on mo/day/yr _____
 Pump test data: Well water was _____ ft. after _____ hours pumping _____ gpm
 Est. Yield _____ gpm: Well water was _____ ft. after _____ hours pumping _____ gpm
 Bore Hole Diameter: 8.5 in. to 25 ft., and _____ in. to _____ ft.
 WELL WATER TO BE USED AS: 5 Public water supply 8 Air conditioning 11 Injection well
 1 Domestic 3 Feedlot 6 Oil field water supply 9 Dewatering 12 Other (Specify below)
 2 Irrigation 4 Industrial 7 Domestic (lawn & garden) 10 Monitoring well mw-1
 Was a chemical/bacteriological sample submitted to Department? Yes _____ No X; If yes, mo/day/yr sample was submitted
 Water Well Disinfected? Yes _____ No X

5] TYPE OF BLANK CASING USED: 5 Wrought iron 8 Concrete tile CASING JOINTS: Glued _____ Clamped _____
 1 Steel 3 RMP (SR) 6 Asbestos-Cement 9 Other (specify below) Welded _____
2 PVC 4 ABS 7 Fiberglass _____ Threaded Flush
 Blank casing diameter 2 in. to 15 ft., Dia _____ in. to _____ ft., Dia _____ in. to _____ ft.
 Casing height above land surface Flush in., weight 703 lbs./ft. Wall thickness or gauge No. Sch 40
 TYPE OF SCREEN OR PERFORATION MATERIAL: 7 PVC 10 Asbestos-cement
 1 Steel 3 Stainless steel 5 Fiberglass 8 RMP (SR) 11 Other (specify) _____
 2 Brass 4 Galvanized steel 6 Concrete tile 9 ABS 12 None used (open hole)
 SCREEN OR PERFORATION OPENINGS ARE: 5 Gauzed wrapped 8 Saw cut 11 None (open hole)
 1 Continuous slot 3 Mill slot 6 Wire wrapped 9 Drilled holes _____ ft.
 2 Louvered shutter 4 Key punched 7 Torch cut 10 Other (specify) _____ ft.
 SCREEN-PERFORATED INTERVALS: From 15 ft. to 25 ft., From _____ ft. to _____ ft.
 From _____ ft. to _____ ft., From _____ ft. to _____ ft.
 GRAVEL PACK INTERVALS: From 13 ft. to 25 ft., From _____ ft. to _____ ft.
 From _____ ft. to _____ ft., From _____ ft. to _____ ft.

6] GROUT MATERIAL: 1 Neat cement 2 Cement grout 3 Bentonite 4 Other _____
 Grout Intervals: From 0.5 ft. to 13 ft., From _____ ft. to _____ ft. to _____ ft. to _____ ft.
 What is the nearest source of possible contamination:
 1 Septic tank 4 Lateral lines 7 Pit privy 11 Fuel storage 14 Abandoned water well
 2 Sewer lines 5 Cess pool 8 Sewage lagoon 12 Fertilizer storage 15 Oil well/Gas well
 3 Watertight sewer lines 6 Seepage pit 9 Feedyard 13 Insecticide storage 16 Other (specify below) _____
 Direction from well? East How many feet? 4

FROM	TO	LITHOLOGIC LOG	FROM	TO	PLUGGING INTERVALS
0	5	Sand & clay			
5	6.5	clay			
6.5	10	med. sand & v. little clay			
10	25	sand			

7] CONTRACTOR'S OR LANDOWNER'S CERTIFICATION: This water well was constructed (2) reconstructed, or (3) plugged under my jurisdiction and was completed on (mo/day/year) 12/7/00 and this record is true to the best of my knowledge and belief. Kansas Water Well Contractor's Licence No. 531 This Water Well Record was completed on (mo/day/yr) 1/15/01 under the business name of Geotechnical Services, Inc by (signature) Allen M. ...