

CORRECTION(S) TO WATER WELL RECORD (WWC-5)
(to rectify lacking or incorrect information)

County: Ford

Location listed as:

Section-Township-Range: 27-26S-25W

Fraction (1/4 1/4 1/4): NE SW SW

Location changed to:

26-26S-25W

NE SW SW

Other changes: Initial statements: _____

Changed to: _____

Comments: _____

verification method: written & legal descriptions, city street map,
and Dodge City 1:24,000 topo map.

initials: RL date: 3/4/2010

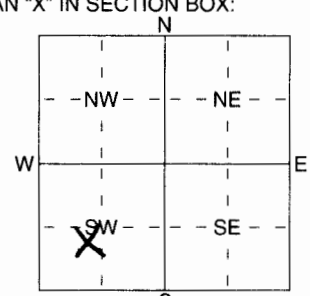
submitted by: Kansas Geological Survey, Data Resources Library, 1930 Constant Ave., Lawrence, KS 66047-3726
to: Kansas Dept of Health & Environment, Bureau of Water, 1000 SW Jackson, Suite 420, Topeka, KS 66612-1367.

5VEW1

1 LOCATION OF WATER WELL: County: Ford Fraction: NE 1/4 SW 1/4 SW 1/4 Section Number: 27 Township Number: T 26 S Range Number: R 25 E/D

Distance and direction from nearest town or city street address of well if located within city?
1108 West Wyatt Exp, Dodge City, KS

2 WATER WELL OWNER: THE MUSKET CORPORATION (MICHAEL KEY)
 RR#, St. Address, Box #: P.O. Box 2620 Board of Agriculture, Division of Water Resources
 City, State, ZIP Code: Oklahoma City, OK 73126 Application Number:

3 LOCATE WELL'S LOCATION WITH AN "X" IN SECTION BOX:

 4 DEPTH OF COMPLETED WELL: 40.0 ft. ELEVATION: 2494.52
 Depth(s) Groundwater Encountered: 1 38.0 ft. 2 38.0 ft. 3 38.0 ft.
 WELL'S STATIC WATER LEVEL: 38.25 ft. below land surface measured on mo/day/yr 8/20/2003
 Pump test data: Well water was _____ ft. after _____ hours pumping _____ gpm
 Est. Yield _____ gpm: Well water was _____ ft. after _____ hours pumping _____ gpm
 WELL WATER TO BE USED AS:
 1 Domestic 3 Feedlot 6 Oil field water supply 9 Dewatering 12 Other (Specify below)
 2 Irrigation 4 Industrial 7 Domestic (lawn & garden) 10 Monitoring well Vapor Extraction
 Was a chemical/bacteriological sample submitted to Department? Yes _____ No X; If yes, mo/day/yr sample was submitted
 Water Well Disinfected? Yes _____ No (No)

5 TYPE OF BLANK CASING USED:
 1 Steel 2 PVC 3 RMP (SR) 4 ABS 5 Wrought iron 6 Asbestos-Cement 7 Fiberglass 8 Concrete tile 9 Other (specify below) CASING JOINTS: Glued _____ Clamped _____
 Welded _____ Threaded X
 Blank casing diameter: 2 in. to 40 ft., Dia _____ in. to _____ ft., Dia _____ in. to _____ ft.
 Casing height above land surface: -4.44 in., weight _____ lbs./ft. Wall thickness or gauge No. 3/4" PVC
 TYPE OF SCREEN OR PERFORATION MATERIAL:
 1 Steel 2 Brass 3 Stainless Steel 4 Galvanized Steel 5 Fiberglass 6 Concrete tile 7 PVC 8 RMP (SR) 9 ABS 10 Asbestos-Cement 11 Other (Specify) _____ 12 None used (open hole)
 SCREEN OR PERFORATION OPENINGS ARE:
 1 Continuous slot 2 Louvered shutter 3 Mill slot 4 Key punched 5 Gauzed wrapped 6 Wire wrapped 7 Torch cut 8 Saw cut 9 Drilled holes 10 Other (specify) _____ 11 None (open hole)
 SCREEN-PERFORATED INTERVALS: From 20 ft. to 40 ft., From _____ ft. to _____ ft., From _____ ft. to _____ ft.
 GRAVEL PACK INTERVALS: From 18 ft. to 40 ft., From _____ ft. to _____ ft., From _____ ft. to _____ ft.

6 GROUT MATERIAL: 1 Neat cement 2 Cement grout 3 Bentonite 4 Other _____
 Grout Intervals: From 1 ft. to 18 ft., From _____ ft. to _____ ft., From _____ ft. to _____ ft.
 What is the nearest source of possible contamination:
 1 Septic tank 2 Sewer lines 3 Watertight sewer lines 4 Lateral lines 5 Cess pool 6 Seepage pit 7 Pit privy 8 Sewage lagoon 9 Feedyard 10 Livestock pens 11 Fuel storage 12 Fertilizer storage 13 Insecticide storage 14 Abandoned water well 15 Oil well/Gas well 16 Other (specify below)
Just Stee
 Direction from well? _____ How many feet? _____

FROM	TO	LITHOLOGIC LOG	FROM	TO	PLUGGING INTERVALS
0	1	Concrete			
1	8	Sand + clay, fill			
8	14	clay, sandy, dry			
14	16	Sand, very fine to fine			
16	25	Sand, fine to coarse			
25	34	Sand & gravel			
34	40	clay, silty, dense			

7 CONTRACTOR'S OR LANDOWNER'S CERTIFICATION: This water well was (1) constructed, (2) reconstructed, or (3) plugged under my jurisdiction and was completed on (mo/day/year) 08/12/2003 and this record is true to the best of my knowledge and belief. Kansas Water Well Contractor's Licence No. 59A This Water Well Record was completed on (mo/day/yr) 09/17/2003 under the business name of Coronado Great Plains, Inc. by (signature) Meghan E. Hume