

CORRECTION(S) TO WATER WELL RECORD (WWC-5)

(to rectify lacking or incorrect information)

County: Ford

Location listed as:

Section-Township-Range: 35-265-25W

Fraction (1/4 1/4 1/4): NE SW NW

Location changed to:

35-265-25W

SW SE NE

Other changes: Initial statements: _____

Changed to: _____

Comments: _____

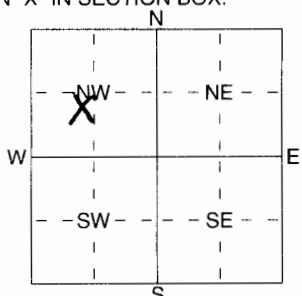
verification method: wellsite address, city street map, and mapping tool on KGS website.

initials: DR date: 2/4/2010

submitted by: Kansas Geological Survey, Data Resources Library, 1930 Constant Ave., Lawrence, KS 66047-3726
to: Kansas Dept of Health & Environment, Bureau of Water, 1000 SW Jackson, Suite 420, Topeka, KS 66612-1367.

1 LOCATION OF WATER WELL: County: Ford Fraction: NE 1/4 SW 1/4 NW 1/4 Section Number: 35 Township Number: T 26 S Range Number: R 25 E
 Distance and direction from nearest town or city street address of well if located within city?
302 So. 2nd St., Dodge City, KS 67801

2 WATER WELL OWNER: South Dodge Lake
 RR#, St. Address, Box #: 302 South 2nd Street Board of Agriculture, Division of Water Resources
 City, State, ZIP Code: Dodge City, KS 67801 Application Number:

3 LOCATE WELL'S LOCATION WITH AN "X" IN SECTION BOX:

 4 DEPTH OF COMPLETED WELL: 40.0 ft. ELEVATION: 2477.45
 Depth(s) Groundwater Encountered: 1 ~ 29 ft. 2 ft. 3 ft.
 WELL'S STATIC WATER LEVEL: 26.35 ft. below land surface measured on mo/day/yr. 12/18/04
 Pump test data: Well water was ft. after hours pumping gpm
 Est. Yield gpm: Well water was ft. after hours pumping gpm
 WELL WATER TO BE USED AS:
 1 Domestic 3 Feedlot 6 Oil field water supply 9 Dewatering 12 Other (Specify below)
 2 Irrigation 4 Industrial 7 Domestic (lawn & garden) 10 Monitoring well
 Was a chemical/bacteriological sample submitted to Department? Yes No X ; If yes, mo/day/yr sample was submitted
 Water Well Disinfected? Yes No

5 TYPE OF BLANK CASING USED:
 1 Steel 3 RMP (SR) 5 Wrought iron 8 Concrete tile CASING JOINTS: Glued Clamped
2 PVC 4 ABS 6 Asbestos-Cement 9 Other (specify below) Welded
 7 Fiberglass Threaded X
 Blank casing diameter: 2 in. to 40 ft., Dia in. to ft., Dia in. to ft.
 Casing height above land surface: -8.88 in., weight lbs./ft. Wall thickness or gauge No. Sch 40 PRC
 TYPE OF SCREEN OR PERFORATION MATERIAL:
 1 Steel 3 Stainless Steel 5 Fiberglass 8 RMP (SR) 10 Asbestos-Cement
 2 Brass 4 Galvanized Steel 6 Concrete tile 9 ABS 11 Other (Specify)
 12 None used (open hole)
 SCREEN OR PERFORATION OPENINGS ARE:
 1 Continuous slot 3 Mill slot 5 Gauzed wrapped 8 Saw cut 11 None (open hole)
 2 Louvered shutter 4 Key punched 6 Wire wrapped 9 Drilled holes
 7 Torch cut 10 Other (specify) ft.
 SCREEN-PERFORATED INTERVALS: From 20 ft. to 40 ft., From ft. to ft.
 From ft. to ft., From ft. to ft.
 GRAVEL PACK INTERVALS: From 16 ft. to 40 ft., From ft. to ft.
 From ft. to ft., From ft. to ft.

6 GROUT MATERIAL: 1 Neat cement 2 Cement grout 3 Bentonite 4 Other
 Grout Intervals: From 1 ft. to 16 ft., From ft. to ft., From ft. to ft.
 What is the nearest source of possible contamination:
 1 Septic tank 4 Lateral lines 7 Pit privy 10 Livestock pens 14 Abandoned water well
 2 Sewer lines 5 Cess pool 8 Sewage lagoon 11 Fuel storage 15 Oil well/Gas well
 3 Watertight sewer lines 6 Seepage pit 9 Feedyard 12 Fertilizer storage 16 Other (specify below)
List Site
 Direction from well? How many feet?

FROM	TO	LITHOLOGIC LOG	FROM	TO	PLUGGING INTERVALS
0	2	Soil			
2	9	Sand, fine grained			
9	22	Sand, gravel to medium			
22	23.5	Clay, fine sand			
23.5	24	Sand, gravel			
24	25.5	Clay, fine sand			
25.5	40	Sand, medium to fine grained			
					SDMW II

7 CONTRACTOR'S OR LANDOWNER'S CERTIFICATION: This water well was (1) constructed, (2) reconstructed, or (3) plugged under my jurisdiction and was completed on (mo/day/year) 11/16/04 and this record is true to the best of my knowledge and belief. Kansas Water Well Contractor's Licence No. 974 This Water Well Record was completed on (mo/day/yr) 12/29/04 under the business name of Covano Great Plains, Inc. by (signature) Robert Allen