


1 LOCATION OF WATER WELL: Fraction **NW ¼ SW ¼ SW ¼** Section Number **25** Township Number **T 26 S** Range Number **R 25 E/W**
 County: **Ford**

Distance and direction from nearest town or city street address of well if located within city? **MW-14**
304 East Wyatt Earp Blvd., Dodge City Kansas.
 Latitude: **N 37° 45.192**, Longitude: **W 100° 00.788**

2 WATER WELL OWNER: **Total Petrochemicals, Inc.**
 RR#, St. Address, Box # : **P.O. Box 674411** Board of Agriculture, Division of Water Resources
 City, State, ZIP Code : **Houston, Texas 77267-4411** Application Number:

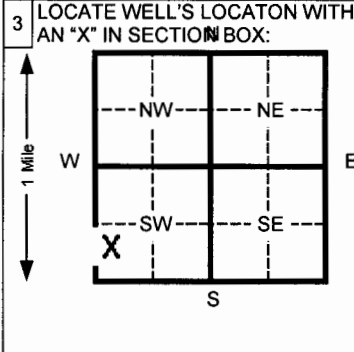

4 DEPTH OF COMPLETED WELL **61.5** ft. ELEVATION: **2499.08**
 Depth(s) Groundwater Encountered 1 **56.8** ft. 2 _____ ft. 3 _____ ft.
 WELL'S STATIC WATER LEVEL **Unknown** ft. below land surface measured on mo/day/yr
 Pump test data: Well water was _____ ft. after _____ hours pumping _____ gpm
 Est. Yield **< 50** gpm: Well water was _____ ft. after _____ hours pumping _____ gpm
 Bore Hole Diameter **8** in. to **61.5** ft. and _____ in. to _____ ft.
 WELL WATER TO BE USED AS: 5 Public water supply 8 Air conditioning 11 Injection well
 1 Domestic 3 Feed lot 6 Oil field water supply 9 Dewatering 12 Other (Specify below)
 2 Irrigation 4 Industrial 7 Lawn and garden (domestic) 10 **Monitoring well**
 Was a chemical/bacteriological sample submitted to Department? Yes _____ No **X** If yes, mo/day/yr sample was submitted
 Water Well Disinfected? Yes _____ No **X**

5 TYPE OF BLANK CASING USED: 5 Wrought Iron 8 Concrete tile CASING JOINTS: Glued _____ Clamped _____
 1 Steel 3 RMP (SR) 6 Asbestos-Cement 9 Other (specify below) Welded _____
 2 **PVC** 4 ABS 7 Fiberglass _____ Threaded **X**
 Blank casing diameter **2** in. to **20** ft., Dia _____ in. to _____ ft., Dia _____ in. to _____ ft.
 Casing height above land surface **-6.0** in., weight **0.682** lbs./ft. Wall thickness or gauge No. **0.154** in.
 TYPE OF SCREEN OR PERFORATION MATERIAL: 7 **PVC** 10 Asbestos-cement
 1 Steel 3 Stainless steel 5 Fiberglass 8 RMP (SR) 11 Other (specify) _____
 2 Brass 4 Galvanized steel 6 Concrete tile 9 ABS 12 None used (open hole)
 SCREEN OR PERFORATION OPENINGS ARE: 5 Gauzed wrapped 8 Saw cut 11 None (open hole)
 1 Continuous slot 3 **Mill slot** 6 Wire wrapped 9 Drilled holes
 2 Louvered shutter 4 Key punched 7 Torch cut 10 Other (specify) _____
 SCREEN-PERFORATED INTERVALS: From **20** ft. to **60** ft. From _____ ft. to _____ ft.
 From _____ ft. to _____ ft. From _____ ft. to _____ ft.
 GRAVEL PACK INTERVALS: From **18** ft. to **61.5** ft. From _____ ft. to _____ ft.
 From _____ ft. to _____ ft. From _____ ft. to _____ ft.

6 GROUT MATERIAL: 1 Neat cement 2 Cement grout **3 Bentonite** 4 Other _____
 Grout Intervals From **1** ft. to **18** ft. From _____ ft. to _____ ft. From _____ ft. to _____ ft.
 What is the nearest source of possible contamination:
 1 Septic tank 4 Lateral lines 7 Pit privy 10 Livestock pens 14 Abandoned water well
 2 Sewer lines 5 Cess pool 8 Sewage lagoon 11 **Fuel storage** 15 Oil well/ Gas well
 3 Watertight sewer lines 6 Seepage pit 9 Feedyard 12 Fertilizer storage 16 Other (specify below)
 13 Insecticide storage
 Direction from well? _____ How many feet? **unknown**

FROM	TO	CODE	LITHOLOGIC LOG	FROM	TO	PLUGGING INTERVALS
0	6	01	Brown silty fat clay			
6	16	01	Brown silty lean clay			
16	17	09	Brown coarse sand			
17	27	01	Brown to green silty lean clay			
27	29	05	Brown silty sand			
29	32	01	Green to brown silty lean clay			
32	44	09	White to brown coarse sand			
44	46	02	Brown sandy silt			
46	49	02	Brown clayey silt w/ some cobbles			
49	51	01	Brown silty lean clay			
51	54	01	Brown lean clay			
54	56	01	Tan to brown silty lean clay			
56	61.5	02	Tan clayey silt			

7 CONTRACTOR'S OR LANDOWNER'S CERTIFICATION: This water well was (1) constructed, (2) reconstructed, or (3) plugged under my jurisdiction and was completed on (mo/day/yr) **4/20/05** and this record is true to the best of my knowledge and belief. Kansas Water Well Contractor's License No. **616** This Water Well Record was completed on (mo/day/yr) **5/2/05** under the business name of **Thiele Geotech, Inc.** by (signature) *[Signature]*

INSTRUCTIONS: Please fill in blanks and circle the correct answers. Send three copies to Kansas Department of Health and Environment, Bureau of Water, Topeka, Kansas 66620-0001. Telephone: 913-296-5545. Send one to WATER WELL OWNER and retain one for your records.