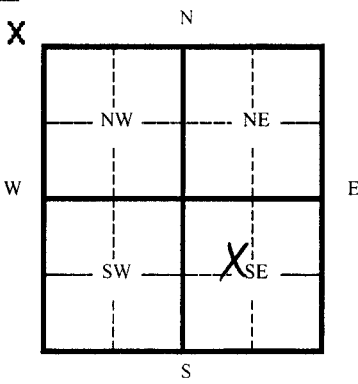


1 LOCATION OF WATER WELL:	Fraction	Section Number	Township Number	Range Number
County: Ford	SE ¼ NW ¼ SE ¼	35	26S	25W

Distance and direction from nearest town or city street address of well if located within city?
603 South Second Avenue, Dodge City, Kansas

2 WATER WELL OWNER: ATOFINA Petrochemicals	Board of Agriculture, Division of Water Resources Application Number:
RR#, St. Address, Box # P.O. Box 674411	
City, State, ZIP Code : Houston, Texas 77267-4411	

3 MARK WELL'S LOCATON WITH AN "X" IN SECTION BOX:


4 DEPTH OF WELL 33.5 ft.
WELL'S STATIC WATER LEVEL nm
WELL WAS USED AS:

1 Domestic
2 Irrigation
3 Feedlot
4 Industrial

5 Public Water Supply
6 Oil Field Water Supply
7 Lawn and Garden (domestic)
8 Air Conditioning

9 Dewatering
10 Monitoring Well
11 Injection Well
12 Other _____

Was a chemical/bacteriological sample submitted to Department? Yes _____ No X
If yes, mo/day/yr sample was submitted _____
Water Well Disinfected: Yes _____ No X

5 TYPE OF BLANK CASING USED:
1 Steel 3 RMP (SR) 5 Wrought 7 Fiberglass 9 Other (specify below)
2 PVC 4 ABC 6 Asbestos-Cement 8 Concrete Tile
Blank casing diameter 2 in. Was casing pulled? Yes X No _____ If yes, how much overdrilled 20 ft.
Casing height above or below land surface 240 in.

6 GROUT PLUG MATERIAL: 1 Neat cement 2 Cement grout 3 Bentonite 4 Other _____
Grout Plug Intervals From 0 ft. to 33.5 ft. From _____ ft. to _____ ft. From _____ ft. to _____ ft.
What is the nearest source of possible contamination:

1 Septic tank
2 Sewer lines
3 Watertight sewer lines
4 Lateral lines
5 Cess Pool

6 Seepage pit
7 Pit privy
8 Sewage lagoon
9 Feedyard
10 Livestock pens

11 Fuel storage
12 Fertilizer storage
13 Insecticide storage
14 Abandoned water well
15 Oil well/ Gas well

16 Other (specify below) _____

Direction from well? Unknown How many feet? Unknown

FROM	TO	CODE	PLUGGING MATERIALS
0	33.5	-	bentonite grout by tremie pipe

7 CONTRACTOR'S OR LANDOWNER'S CERTIFICATION: This water well was plugged under my jurisdiction and was completed on (mo/day/yr) April 17-20, 2005 and this record is true to the best of my knowledge and belief. Kansas Water Well Contractor's License No. 616 This Water Well Record was completed on (mo/day/yr) 8/2/05 under the business name of Thiele Geotech, Inc.
by (signature) [Signature]

INSTRUCTIONS: Please fill in blanks and circle the correct answers. Send three copies to Kansas Department of Health and Environment, Bureau of Water, 1000 S W Jackson St., Ste. 420, Topeka, Kansas 66620-0001. Telephone: 785-296-3565. Send one to Water Well Owner and retain one for your records.

Form provided by Forms On-A-Disk, Inc. · Dallas, Texas · (214) 340-9429