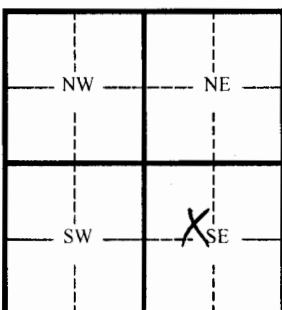


1 LOCATION OF WATER WELL:		Fraction	Section Number	Township Number	Range Number
County: Ford		SE 1/4 NW 1/4 SE 1/4	35	26S	25W
Distance and direction from nearest town or city street address of well if located within city? 608 South Second Avenue, Dodge City, Kansas					
2 WATER WELL OWNER: ATOFINA Petrochemicals					
RR#, St. Address, Box # P.O. Box 674411		Board of Agriculture, Division of Water Resources			
City, State, ZIP Code : Houston, Texas 77267-4411		Application Number:			
3 MARK WELL'S LOCATION WITH AN "X" IN SECTION BOX:		4 DEPTH OF WELL <u>21.4 ft.</u>			
<div style="text-align: center;">N X W E S</div> 		WELL'S STATIC WATER LEVEL <u>dry</u>			
		WELL WAS USED AS:			
		1 Domestic 5 Public Water Supply 9 Dewatering			
		2 Irrigation 6 Oil Field Water Supply 10 <u>Monitoring Well</u>			
		3 Feedlot 7 Lawn and Garden (domestic) 11 Injection Well			
		4 Industrial 8 Air Conditioning 12 Other _____			
		Was a chemical/bacteriological sample submitted to Department? Yes _____ No <u>X</u>			
		If yes, mo/day/yr sample was submitted _____			
		Water Well Disinfected: Yes _____ No <u>X</u>			
5 TYPE OF BLANK CASING USED:					
1 Steel 3 RMP (SR) 5 Wrought 7 Fiberglass 9 Other (specify below)					
2 <u>PVC</u> 4 ABC 6 Asbestos-Cement 8 Concrete Tile					
Blank casing diameter <u>2</u> in. Was casing pulled? Yes <u>X</u> No _____ If yes, how much <u>overdrilled 20 ft.</u>					
Casing height above or below land surface <u>240</u> in.					
6 GROUT PLUG MATERIAL: 1 Neat cement 2 Cement grout 3 <u>Bentonite</u> 4 Other _____					
Grout Plug Intervals From <u>0</u> ft. to <u>21.4</u> ft. From _____ ft. to _____ ft. From _____ ft. to _____ ft.					
What is the nearest source of possible contamination:					
1 Septic tank 6 Seepage pit 11 <u>Fuel storage</u> 16 Other (specify below)					
2 Sewer lines 7 Pit privy 12 Fertilizer storage					
3 Watertight sewer lines 8 Sewage lagoon 13 Insecticide storage					
4 Lateral lines 9 Feedyard 14 Abandoned water well					
5 Cess Pool 10 Livestock pens 15 Oil well/ Gas well					
Direction from well? <u>Unknown</u> How many feet? <u>Unknown</u>					
FROM	TO	CODE	PLUGGING MATERIALS		
<u>0</u>	<u>21.4</u>	<u>-</u>	<u>bentonite grout by tremie pipe</u>		
7 CONTRACTOR'S OR LANDOWNER'S CERTIFICATION: This water well was plugged under my jurisdiction and was completed on (mo/day/yr) <u>April 17-20, 2005</u> and this record is true to the best of my knowledge and belief. Kansas Water Well Contractor's License No. <u>616</u> This Water Well Record was completed on (mo/day/yr) <u>8/2/05</u> under the business name of <u>Thiele Geotech, Inc.</u> by (signature) <u>[Signature]</u>					
INSTRUCTIONS: Please fill in blanks and circle the correct answers. Send three copies to Kansas Department of Health and Environment, Bureau of Water, 1000 S W Jackson St., Ste. 420, Topeka, Kansas 66620-0001. Telephone: 785-296-3565. Send one to Water Well Owner and retain one for your records.					