


1 LOCATION OF WATER WELL:	Fraction	Section Number	Township Number	Range Number
County: <b>Ford</b>	<b>SE ¼ NW ¼ SE ¼</b>	<b>35</b>	<b>26S</b>	<b>25W</b>

Distance and direction from nearest town or city street address of well if located within city?  
**607 South Second Avenue, Dodge City, Kansas**

2 WATER WELL OWNER: <b>ATOFINA Petrochemicals</b>	Board of Agriculture, Division of Water Resources Application Number:
RR#, St. Address, Box # <b>P.O. Box 674411</b>	
City, State, ZIP Code : <b>Houston, Texas 77267-4411</b>	

3 MARK WELL'S LOCATION WITH AN "X" IN SECTION BOX:	4 DEPTH OF WELL <u>39 ft.</u>
--	-------------------------------

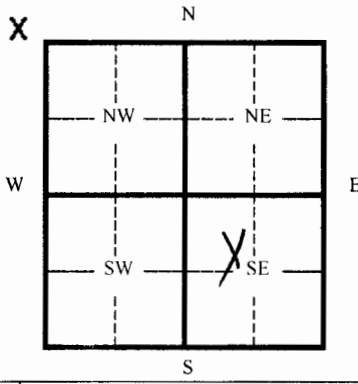

WELL'S STATIC WATER LEVEL 30.03 ft.

WELL WAS USED AS:

1 Domestic	5 Public Water Supply	9 Dewatering
2 Irrigation	6 Oil Field Water Supply	10 <u>Monitoring Well</u>
3 Feedlot	7 Lawn and Garden (domestic)	11 Injection Well
4 Industrial	8 Air Conditioning	12 Other

Was a chemical/bacteriological sample submitted to Department? Yes      No X

If yes, mo/day/yr sample was submitted                     

Water Well Disinfected: Yes      No X

5 TYPE OF BLANK CASING USED:				
1 Steel	3 RMP (SR)	5 Wrought	7 Fiberglass	9 Other (specify below)
2 <u>PVC</u>	4 ABC	6 Asbestos-Cement	8 Concrete Tile	
Blank casing diameter <u>2</u> in. Was casing pulled? Yes <u>X</u> No <u>    </u> If yes, how much <u>overdrilled 20 ft.</u>				
Casing height above or below land surface <u>240</u> in.				

6 GROUT PLUG MATERIAL: 1 Neat cement 2 Cement grout 3 <u>Bentonite</u> 4 Other				
Grout Plug Intervals From <u>0</u> ft. to <u>39</u> ft. From <u>    </u> ft. to <u>    </u> ft. From <u>    </u> ft. to <u>    </u> ft.				
What is the nearest source of possible contamination:				
1 Septic tank	6 Seepage pit	11 <u>Fuel storage</u>	16 Other (specify below)	
2 Sewer lines	7 Pit privy	12 Fertilizer storage		
3 Watertight sewer lines	8 Sewage lagoon	13 Insecticide storage		
4 Lateral lines	9 Feedyard	14 Abandoned water well		
5 Cess Pool	10 Livestock pens	15 Oil well/ Gas well		
Direction from well? <u>Unknown</u> How many feet? <u>Unknown</u>				

FROM	TO	CODE	PLUGGING MATERIALS
<u>0</u>	<u>39</u>	<u>-</u>	<u>bentonite grout by tremie pipe</u>

7 CONTRACTOR'S OR LANDOWNER'S CERTIFICATION: This water well was plugged under my jurisdiction and was completed on (mo/day/yr) <u>April 17-20, 2005</u> and this record is true to the best of my knowledge and belief. Kansas Water Well Contractor's License No. <u>616</u> This Water Well Record was completed on (mo/day/yr) <u>8/2/05</u> under the business name of <u>Thiele Geotech, Inc.</u>	
by (signature) <u>[Signature]</u>	

INSTRUCTIONS: Please fill in blanks and circle the correct answers. Send three copies to Kansas Department of Health and Environment, Bureau of Water, 1000 S W Jackson St., Ste. 420, Topeka, Kansas 66620-0001. Telephone: 785-296-3565. Send one to Water Well Owner and retain one for your records.