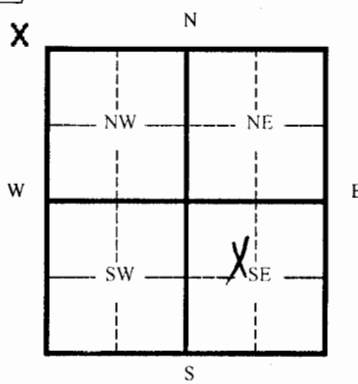


1 LOCATION OF WATER WELL:	Fraction	Section Number	Township Number	Range Number
County: Ford	SE ¼ NW ¼ SE ¼	35	26S	25W

Distance and direction from nearest town or city street address of well if located within city?
608 South Second Avenue, Dodge City, Kansas

2 WATER WELL OWNER: ATOFINA Petrochemicals RR#, St. Address, Box # P.O. Box 674411 City, State, ZIP Code : Houston, Texas 77267-4411	Board of Agriculture, Division of Water Resources Application Number: _____
---	--

3 MARK WELL'S LOCATION WITH AN "X" IN SECTION BOX:


4 DEPTH OF WELL 38.95 ft.
WELL'S STATIC WATER LEVEL 29.76 ft.
WELL WAS USED AS:

1 Domestic	5 Public Water Supply	9 Dewatering
2 Irrigation	6 Oil Field Water Supply	10 <u>Monitoring Well</u>
3 Feedlot	7 Lawn and Garden (domestic)	11 Injection Well
4 Industrial	8 Air Conditioning	12 Other _____

Was a chemical/bacteriological sample submitted to Department? Yes _____ No X
If yes, mo/day/yr sample was submitted _____
Water Well Disinfected: Yes _____ No X

5 TYPE OF BLANK CASING USED:
1 Steel 3 RMP (SR) 5 Wrought 7 Fiberglass 9 Other (specify below)
2 PVC 4 ABC 6 Asbestos-Cement 8 Concrete Tile
Blank casing diameter 2 in. Was casing pulled? Yes X No _____ If yes, how much overdrilled 20 ft.
Casing height above or below land surface 240 in.

6 GROUT PLUG MATERIAL: 1 Neat cement 2 Cement grout 3 Bentonite 4 Other _____
Grout Plug Intervals From 0 ft. to 38.95 ft. From _____ ft. to _____ ft. From _____ ft. to _____ ft.
What is the nearest source of possible contamination:

1 Septic tank	6 Seepage pit	11 <u>Fuel storage</u>	16 Other (specify below)
2 Sewer lines	7 Pit privy	12 Fertilizer storage	
3 Watertight sewer lines	8 Sewage lagoon	13 Insecticide storage	
4 Lateral lines	9 Feedyard	14 Abandoned water well	
5 Cess Pool	10 Livestock pens	15 Oil well/ Gas well	

Direction from well? Unknown How many feet? Unknown

FROM	TO	CODE	PLUGGING MATERIALS
<u>0</u>	<u>38.95</u>	<u>-</u>	<u>bentonite grout by tremie pipe</u>

7 CONTRACTOR'S OR LANDOWNER'S CERTIFICATION: This water well was plugged under my jurisdiction and was completed on (mo/day/yr) April 17-20, 2005 and this record is true to the best of my knowledge and belief. Kansas Water Well Contractor's License No. 616 This Water Well Record was completed on (mo/day/yr) 8/2/05 under the business name of Thiele Geotech, Inc.
by (signature) D. J. A. [Signature]

INSTRUCTIONS: Please fill in blanks and circle the correct answers. Send three copies to Kansas Department of Health and Environment, Bureau of Water, 1000 S W Jackson St., Ste. 420, Topeka, Kansas 66620-0001. Telephone: 785-296-3565. Send one to Water Well Owner and retain one for your records.