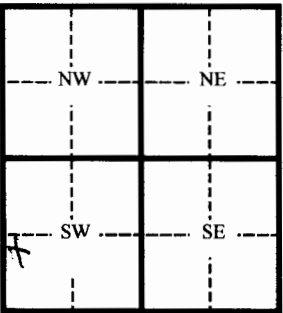


1 LOCATION OF WATER WELL:	Fraction	Section Number	Township Number	Range Number
County: <b>Ford</b>	<b>NW 1/4 SW 1/4 SW 1/4</b>	<b>35</b>	<b>26</b>	<b>25</b>

Distance and direction from nearest town or city street address of well if located within city?

2 WATER WELL OWNER: <b>River Stop</b>	Board of Agriculture, Division of Water Resources Application Number: <b>MW 4</b>
RR#, St. Address, Box # <b>705 S 14<sup>th</sup> St.</b>	
City, State, ZIP Code : <b>Dodge City, Ks</b>	

3 MARK WELL'S LOCATON WITH AN "X" IN SECTION BOX:	4 DEPTH OF WELL <b>17.1</b> ft.												
	WELL'S STATIC WATER LEVEL <b>dry</b> ft.												
	WELL WAS USED AS:												
	<table><tr><td>1 Domestic</td><td>5 Public Water Supply</td><td>9 Dewatering</td></tr><tr><td>2 Irrigation</td><td>6 Oil Field Water Supply</td><td><input checked="" type="checkbox"/> 10 Monitoring Well</td></tr><tr><td>3 Feedlot</td><td>7 Lawn and Garden (domestic)</td><td>11 Injection Well</td></tr><tr><td>4 Industrial</td><td>8 Air Conditioning</td><td>12 Other</td></tr></table>	1 Domestic	5 Public Water Supply	9 Dewatering	2 Irrigation	6 Oil Field Water Supply	<input checked="" type="checkbox"/> 10 Monitoring Well	3 Feedlot	7 Lawn and Garden (domestic)	11 Injection Well	4 Industrial	8 Air Conditioning	12 Other
	1 Domestic	5 Public Water Supply	9 Dewatering										
2 Irrigation	6 Oil Field Water Supply	<input checked="" type="checkbox"/> 10 Monitoring Well											
3 Feedlot	7 Lawn and Garden (domestic)	11 Injection Well											
4 Industrial	8 Air Conditioning	12 Other											
	Was a chemical/bacteriological sample submitted to Department? Yes ___ No <b>X</b> If yes, mo/day/yr sample was submitted _____ Water Well Disinfected: Yes ___ No <b>X</b>												

5 TYPE OF BLANK CASING USED:										
<table><tr><td>1 Steel</td><td>3 RMP (SR)</td><td>5 Wrought</td><td>7 Fiberglass</td><td>9 Other (specify below)</td></tr><tr><td><input checked="" type="checkbox"/> 2 PVC</td><td>4 ABC</td><td>6 Asbestos-Cement</td><td>8 Concrete Tile</td><td></td></tr></table>	1 Steel	3 RMP (SR)	5 Wrought	7 Fiberglass	9 Other (specify below)	<input checked="" type="checkbox"/> 2 PVC	4 ABC	6 Asbestos-Cement	8 Concrete Tile	
1 Steel	3 RMP (SR)	5 Wrought	7 Fiberglass	9 Other (specify below)						
<input checked="" type="checkbox"/> 2 PVC	4 ABC	6 Asbestos-Cement	8 Concrete Tile							
Blank casing diameter _____ in. Was casing pulled? Yes <b>X</b> No _____ If yes, how much <b>8 ft casing, 10 ft. screen</b>										
Casing height above or below land surface <b>0</b> in.										

6 GROUT PLUG MATERIAL: 1 Neat cement 2 Cement grout 3 Bentonite 4 Other
Grout Plug Intervals From _____ ft. to _____ ft. From _____ ft. to _____ ft. From _____ ft. to _____ ft.

What is the nearest source of possible contamination:

- |                          |                   |                         |                          |
|--------------------------|-------------------|-------------------------|--------------------------|
| 1 Septic tank            | 6 Seepage pit     | 11 Fuel storage         | 16 Other (specify below) |
| 2 Sewer lines            | 7 Pit privy       | 12 Fertilizer storage   |                          |
| 3 Watertight sewer lines | 8 Sewage lagoon   | 13 Insecticide storage  |                          |
| 4 Lateral lines          | 9 Feedyard        | 14 Abandoned water well |                          |
| 5 Cess Pool              | 10 Livestock pens | 15 Oil well/ Gas well   |                          |

Direction from well? \_\_\_\_\_ How many feet? \_\_\_\_\_

FROM	TO	CODE	PLUGGING MATERIALS
			Overdrilled to 3 ft, bit kicked off after 4 ft
17.1	3		Bentonite chips
3	0		cement

7 CONTRACTOR'S OR LANDOWNER'S CERTIFICATION: This water well was plugged under my jurisdiction and was completed on (mo/day/yr) <b>1-04-06</b> and this record is true to the best of my knowledge and belief. Kansas Water Well Contractor's License No. <b>554</b> This Water Well Record was completed on (mo/day/yr) <b>2-24-06</b> under the business name of <b>Woofter Pump &amp; Well Inc.</b> by (signature) _____
--

INSTRUCTIONS: Please fill in blanks and circle the correct answers. Send three copies to Kansas Department of Health and Environment, Bureau of Water, 1000 S W Jackson St., Ste. 420, Topeka, Kansas 66620-0001. Telephone: 785-296-3565. Send one to Water Well Owner and retain one for your records.