


1 LOCATION OF WATER WELL: Fraction SW ¼ SE ¼ NE ¼ Section Number 35 Township Number 26 Range Number 25 (W)
 County: Ford
 Distance and direction from nearest town or city street address of well if located within city?
301 South 2nd Street, Dodge City, KS 67801

2 WATER WELL OWNER: Fas Stop **Global Positioning System** (decimal degrees, min. of 4 digits)
 RR#, St. Address, Box #: 301 South 2nd Street
 City, State, ZIP Code: Dodge City, KS 67801
 Latitude: _____
 Longitude: _____
 Elevation: _____
 Datum: _____
 Data Collection Method: _____

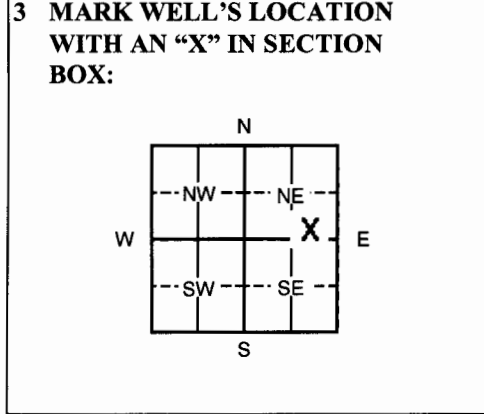

4 DEPTH OF WELL 19 ft.
 WELL'S STATIC WATER LEVEL _____ ft.
 WELL WAS USED AS:
 1 Domestic 5 Public Water Supply 9 Dewatering
 2 Irrigation 6 Oil Field Water Supply 10 Monitoring
 3 Feedlot 7 Domestic (Lawn & Garden) 11 Injection Well
 4 Industrial 8 Air Conditioning 12 Other Vapor Extraction
 Was a chemical/bacteriological sample submitted to Department? Yes ___ No X

5 TYPE OF BLANK CASING USED:
 1 Steel 3 RMP (SR) 5 Wrought 7 Fiberglass 9 Other (Specify below) _____
 (2 PVC) 4 ABS 6 Asbestos-Cement 8 Concrete Tile _____
 Blank casing diameter 4 in. Was casing pulled? Yes X No ___ If yes, how much 3'
 Casing height above or below land surface _____ in.

6 GROUT PLUG MATERIAL: 1 Neat cement 2 Cement grout (3 Bentonite) 4 Other _____
 Grout Plug Intervals: From 3 ft. to 19 ft., From _____ ft. to _____ ft., From _____ to _____ ft.

What is the nearest source of possible contamination:
 1 Septic tank 6 Seepage pit 11 Fuel Storage 16 Other (specify below) _____
 2 Sewer lines 7 Pit privy 12 Fertilizer storage Lust Site
 3 Watertight sewer lines 8 Sewage lagoon 13 Insecticide storage
 4 Lateral lines 9 Feedyard 14 Abandoned water well Direction from well? _____
 5 Cess pool 10 Livestock pens 15 Oil well/Gas well How many feet? _____

FROM	TO	PLUGGING MATERIALS	FROM	TO	PLUGGING MATERIALS
0	1	Concrete			
1	3	Native Soil			
3	19	Bentonite Solids 20 – 30%			FSSVE5

7 CONTRACTOR'S OR LANDOWNER'S CERTIFICATION: This water well was plugged under my jurisdiction and was completed on (mo/day/year) 02/13/2007 and this record is true to the best of my knowledge and belief. Kansas Water Well Contractor's License No. 594. This Water Well Record was completed on (mo/day/year) 03/22/2007 under the business name of Coranco Great Plains, Inc. by (signature) [Signature]

INSTRUCTIONS: Please fill in blanks or circle the correct answers. Send top three copies to Kansas Department of Health and Environment, Bureau of Water, Geology Section, 1000 SW Jackson St., Ste. 420, Topeka, Kansas 66612-1367. Telephone: 785/296-5522. Send one to Water Well Owner and retain one for your records. Visit us at <http://www.kdheks.gov/waterwell>.